


G-1114

28605

T.6N.R.35&36E.W.M.

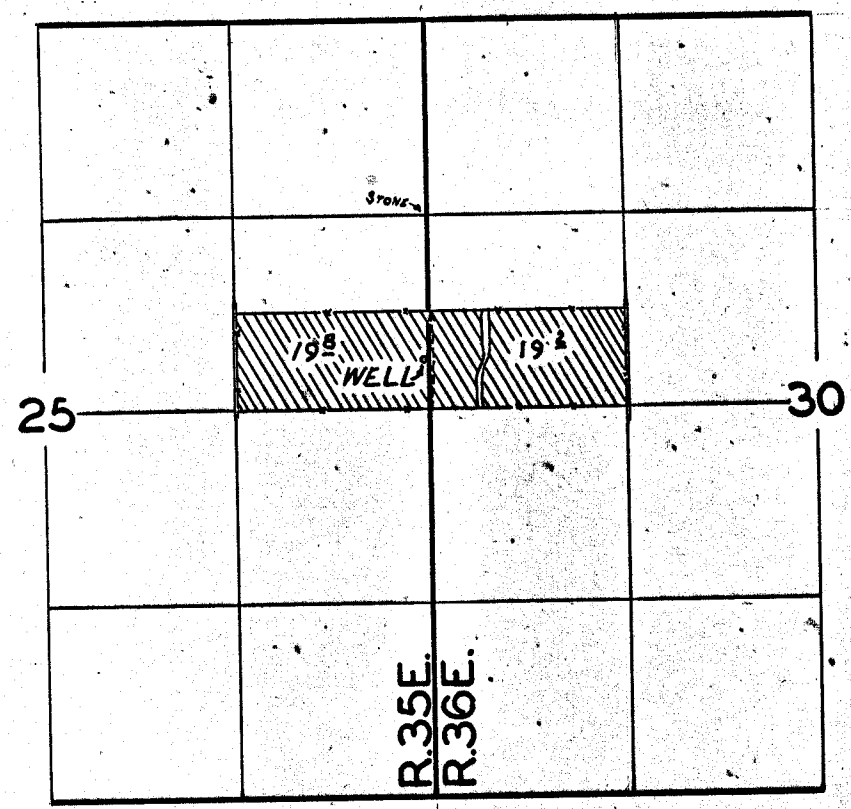

FINAL PROOF SURVEY UNDER

Application No. *G.1214* Permit No. *G.1114*
IN NAME OF

HAROLD STILLER

Surveyed *JULY 12, 1960*, by *M. BISH*

NZ-6P-64