


FINAL PROOF MAP IN THE NAME OF
STEVE BIZON

T-9367

T 4 S, R 1 W, W.M. Section 31 & 32


REVISED 2-27-2014

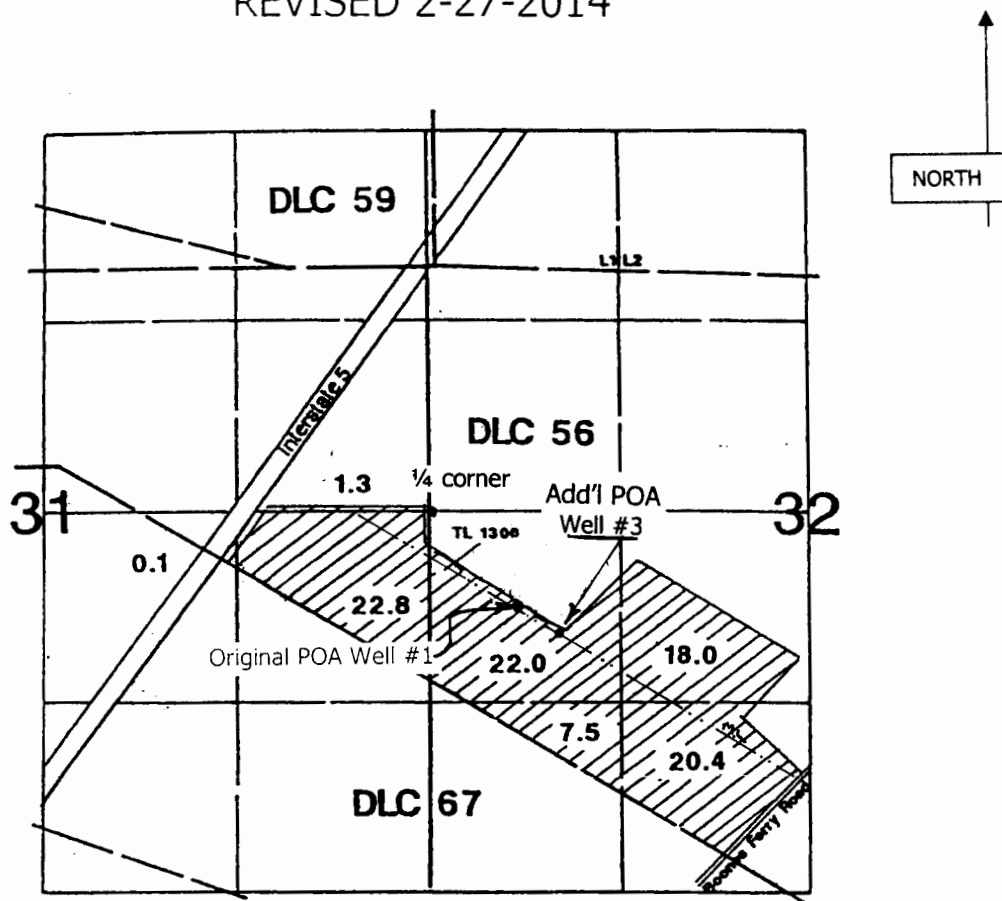

Well #1: 690' south & 620' east from the 1/4 corner section 31 & 32

Well #3: 850' S & 870' E from the 1/4 corner sections 31 & 32

Scale 1" = 1320'

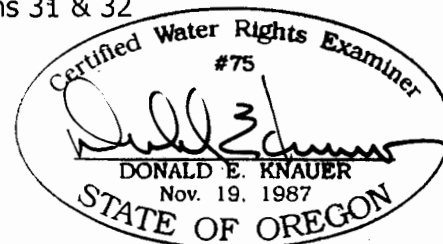

RENEWAL DATE: 6/30/2009

6/30/2015

This map is for water right purposes only.