


T. 9 S. R. 4 W. W.M.

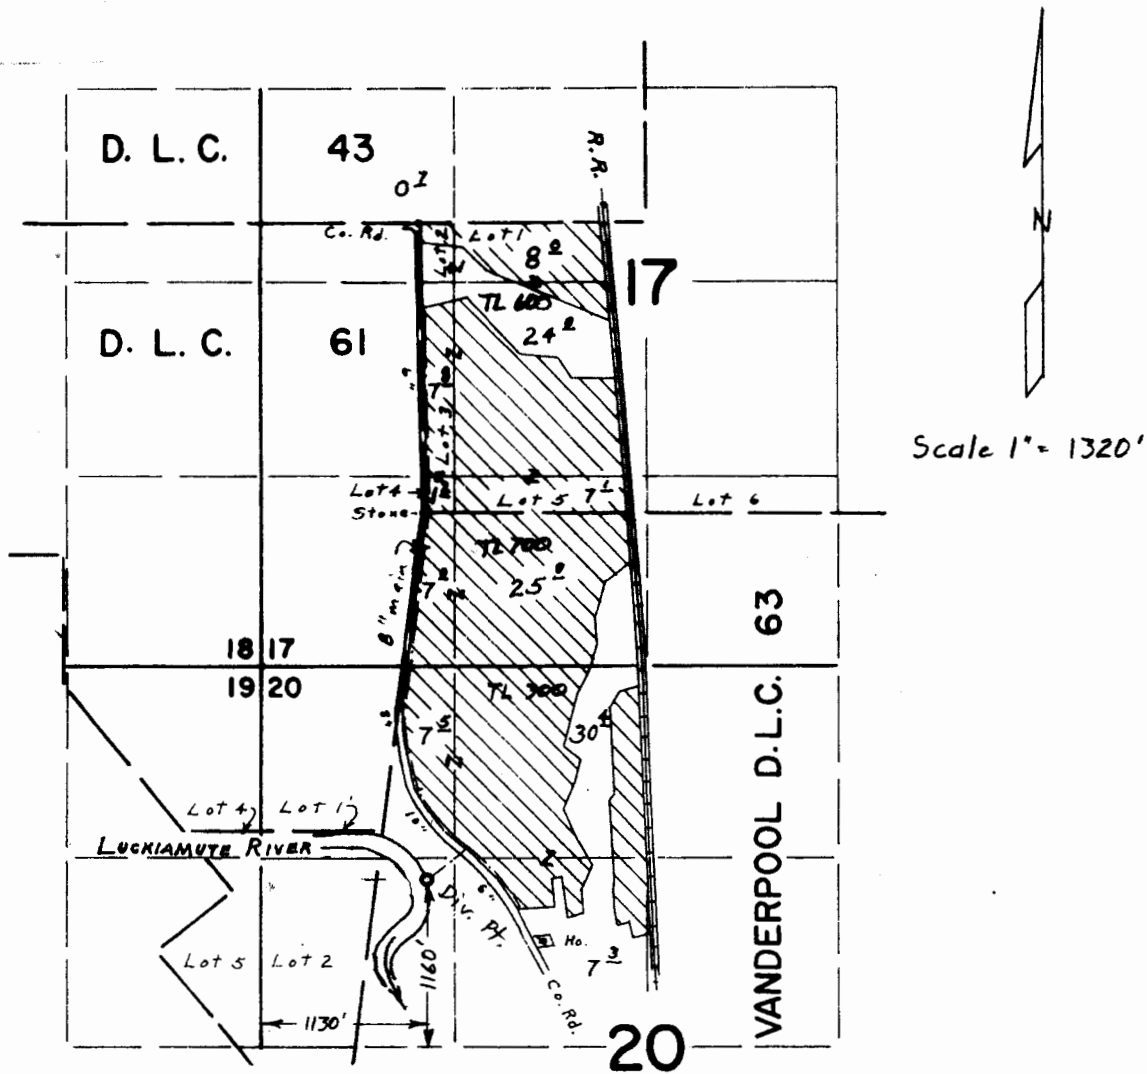


Div. Pt. located 2530' S. & 30' E. from N.W. Cor. Vanderpool D.L.C. 63

Surveyed Sept. 15, 2003

Claim of Beneficial Use Map
for
SPERLING

T-8749

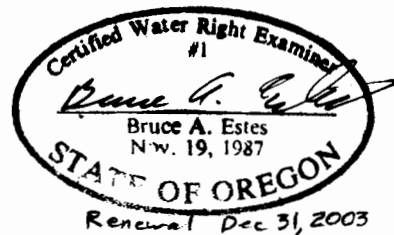

This map is for the purpose of locating a water right only and has no intent to provide legal dimensions or the location of property lines.

ESTES SURVEYS, LLC

PO Box 17519 Salem, OR 97305-7519 (503) 585-7593
60382 Arnold Rd Bend, OR 97702 (541) 382-7391