
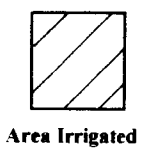


T.4S., R.1W., W.M.

SEP 26, 2003

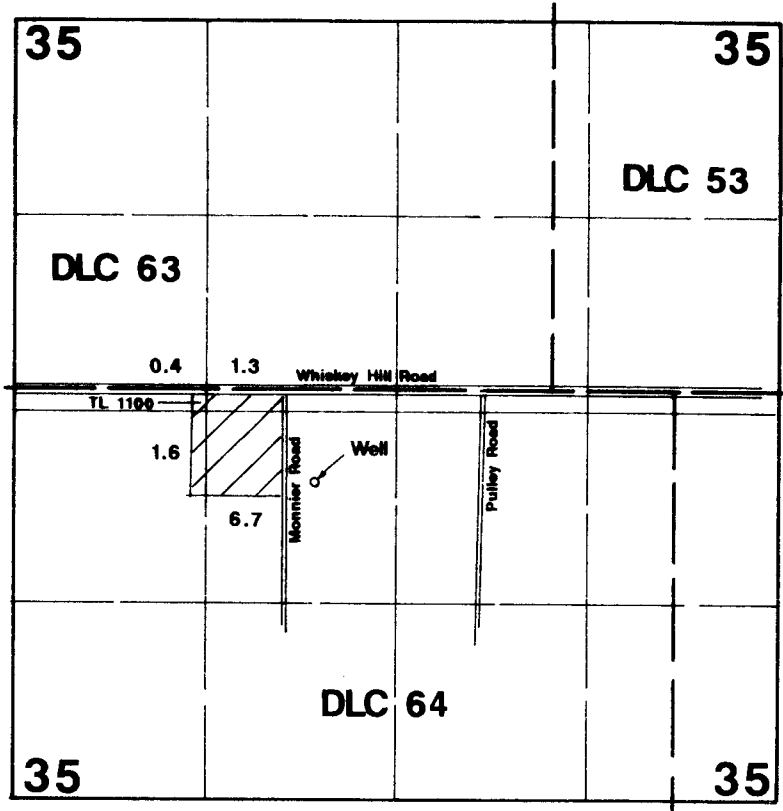

Well is located 615' S & 2490' W from the ^{NE}~~SW~~ corner of DLC 64.
JMS 3/26/14

Final Proof Survey

In Name of

Dieringer Nursery

Application #: G-14491

Permit #: G-13352

Surveyed on September 18, 2003 by JM Schuette

This Map Was Prepared For The Purpose Of Identifying The Location Of A Water Right Only And Is Not Intended To Provide Legal Dimensions Or Location Of Property Ownership Lines.

