


T.5S. R.1E. Sec. 11 & 12, W.M.

RECEIVED

OCT 11 2009

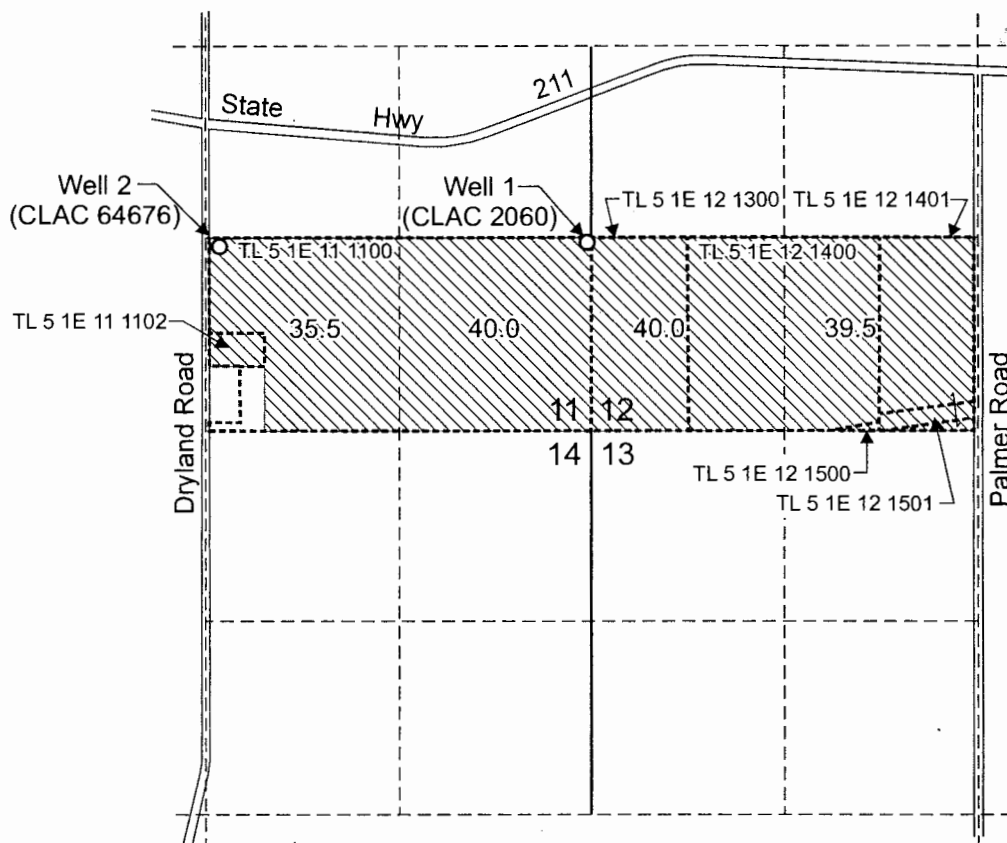

Well 1 (CLAC 2060) is located 1,290 feet north and 30 feet west from the SE corner of Section 11.

Well 2 (CLAC 64676) is located 1,260 feet north and 2,540 feet west from the SE corner of Section 11.

Area (155.0 Acres) irrigated under Transfer 10201.

----- Tax lot boundary



EXPIRATION DATE: 6/30/2011

Scale: 1" = 1,320'



This map was prepared for the purpose of identifying the location of a water right only and is not intended to provide legal dimensions or location of property ownership lines.

Claim of Beneficial Use Map

T-10201

Stefan Tipikin

T.5S. R.1E. Sec. 11 & 12, W.M.

Pacific Hydro-Geology Inc.

09/2009