



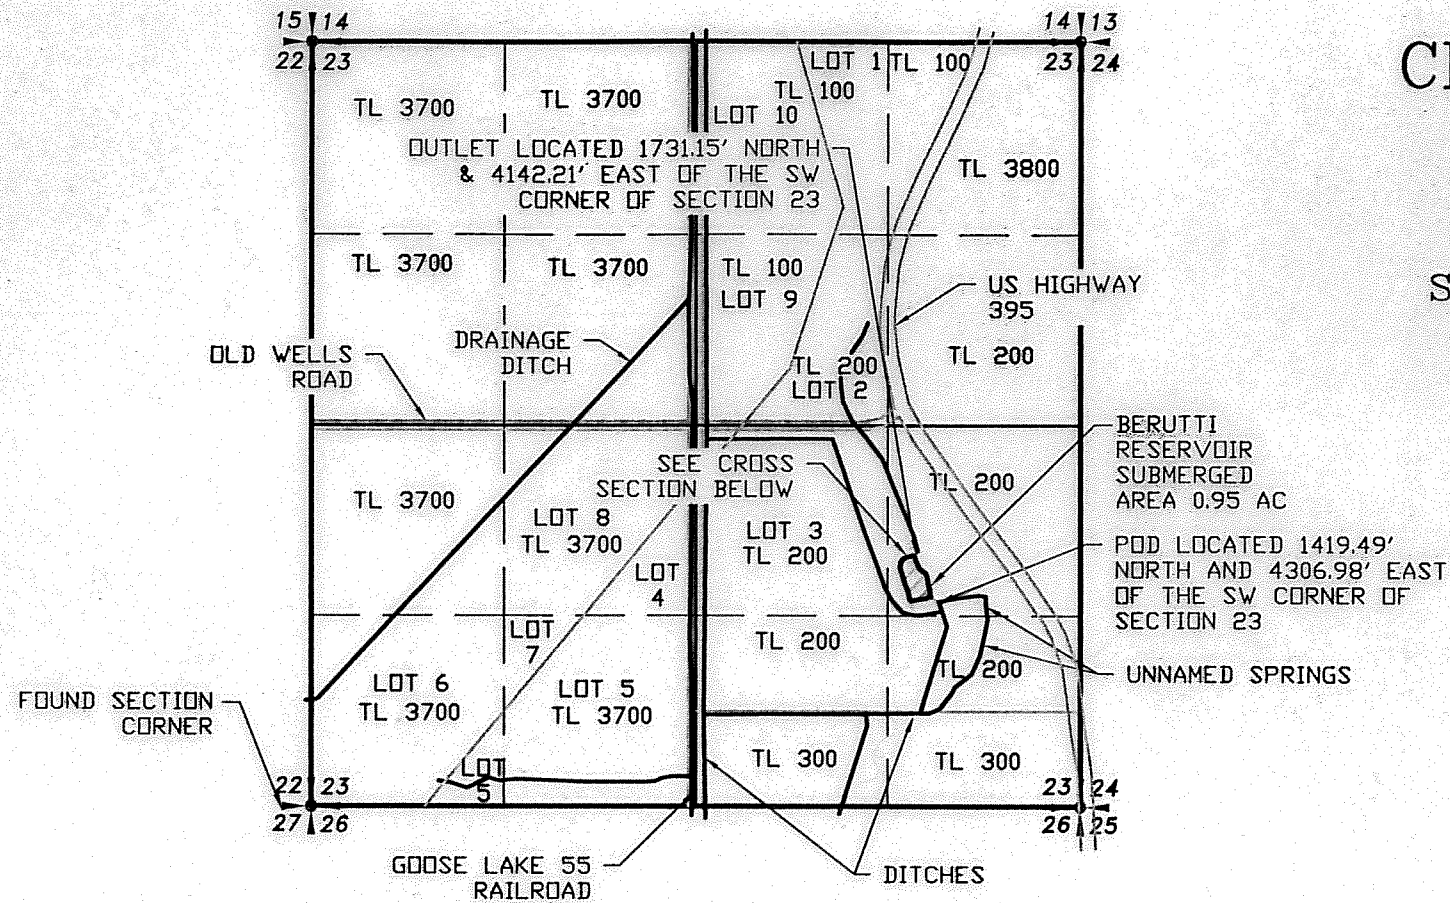


CLAIM OF BENEFICIAL USE MAP

FOR

SUSAN BERUTTI-BAIRD

SECTION 23, TOWNSHIP 40 SOUTH RANGE 20 EAST,
LAKE COUNTY, OREGON

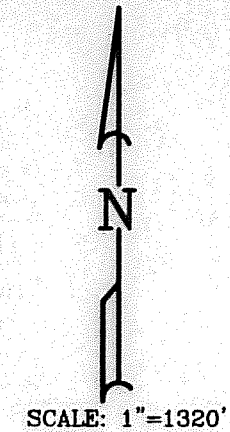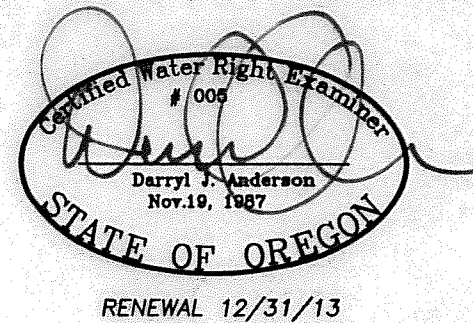


LEGEND

- SECTION LINE
- 1/4 SECTION LINE
- 1/16 SECTION LINE
- DITCHES



RECEIVED BY OWRD
DEC 09 2013
SALEM, OR

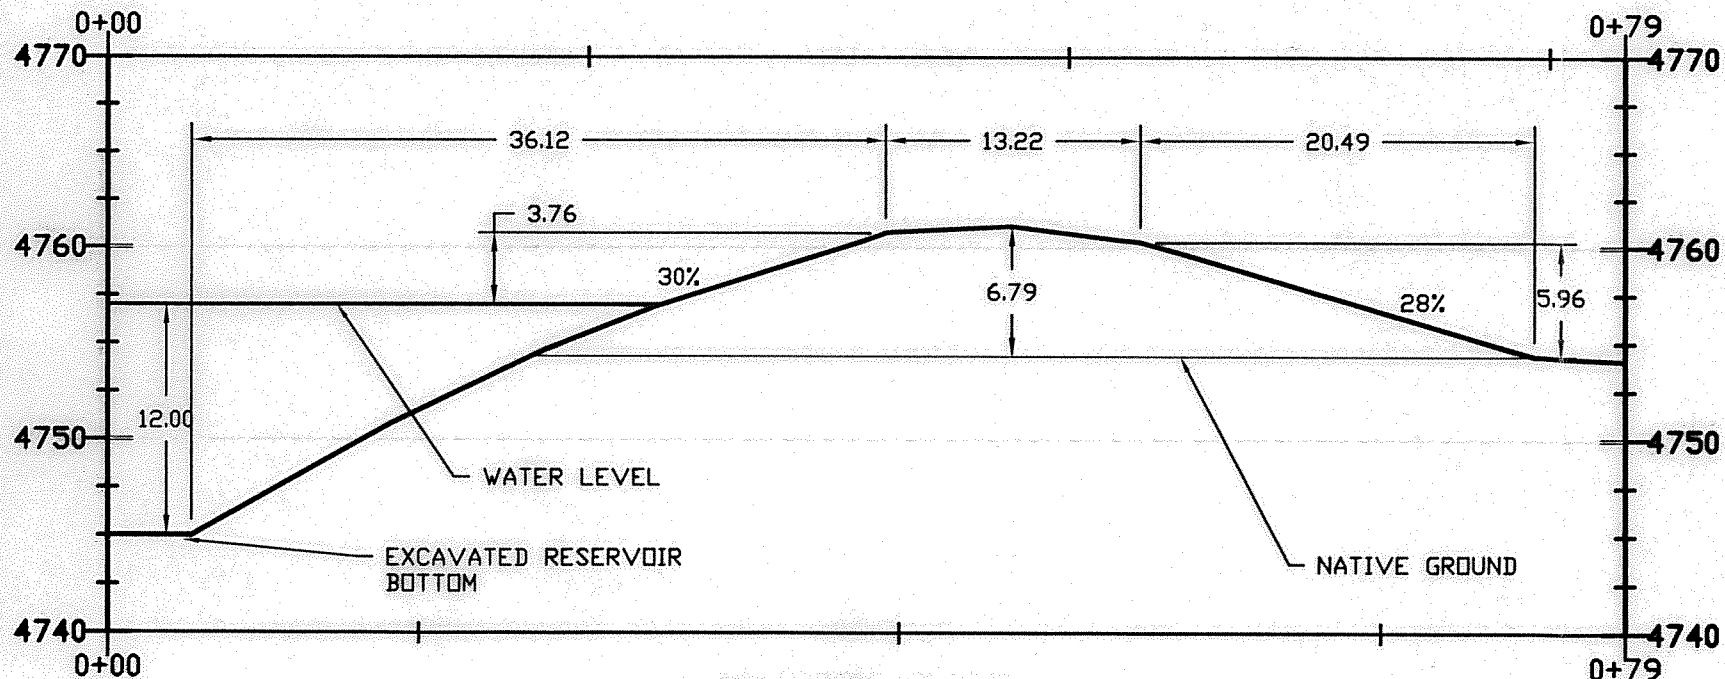

APPLICATION NO. R-74425
PERMIT NO. R-12520

NOTE:
PREPARATION OF THIS MAP IS FOR IDENTIFYING PROPOSED
WATER RIGHTS ONLY. IT HAS NO INTENT TO PROVIDE
LOCATIONS OR DIMENSIONS OF PROPERTY BOUNDARIES.

RECEIVED BY OWRD

COBU MAP #802

NOV 20 2013

SALEM, OR

REVISION	BY

**ANDERSON ENGINEERING
AND SURVEYING, INC.**
P.O. BOX 28
LAKEVIEW, OREGON 97630
(541) 947-4407
FAX: 947-2321

FOR:
SUSAN BERUTTI-BAIRD
14472 HIGHWAY 396
LAKEVIEW, OR
97630

CLAIM OF BENEFICIAL USE
74425
PERMIT NO. R-12520

DATE: 11/07/13
SCALE: 1"=1320'
DWG. BY: R.C.
JOB: 2009-045
FILE: 2009-045
SHEET: 1 OF 1