


MAP

Accompanying Final Proof on application #12304
 permit #8710 in name of HENRY LUMBER COMPANY of
 Ashland, Oregon, showing correctly Location of supply
 and points of use from Plane Table Survey by Chester
 Cummings.

September 1930.

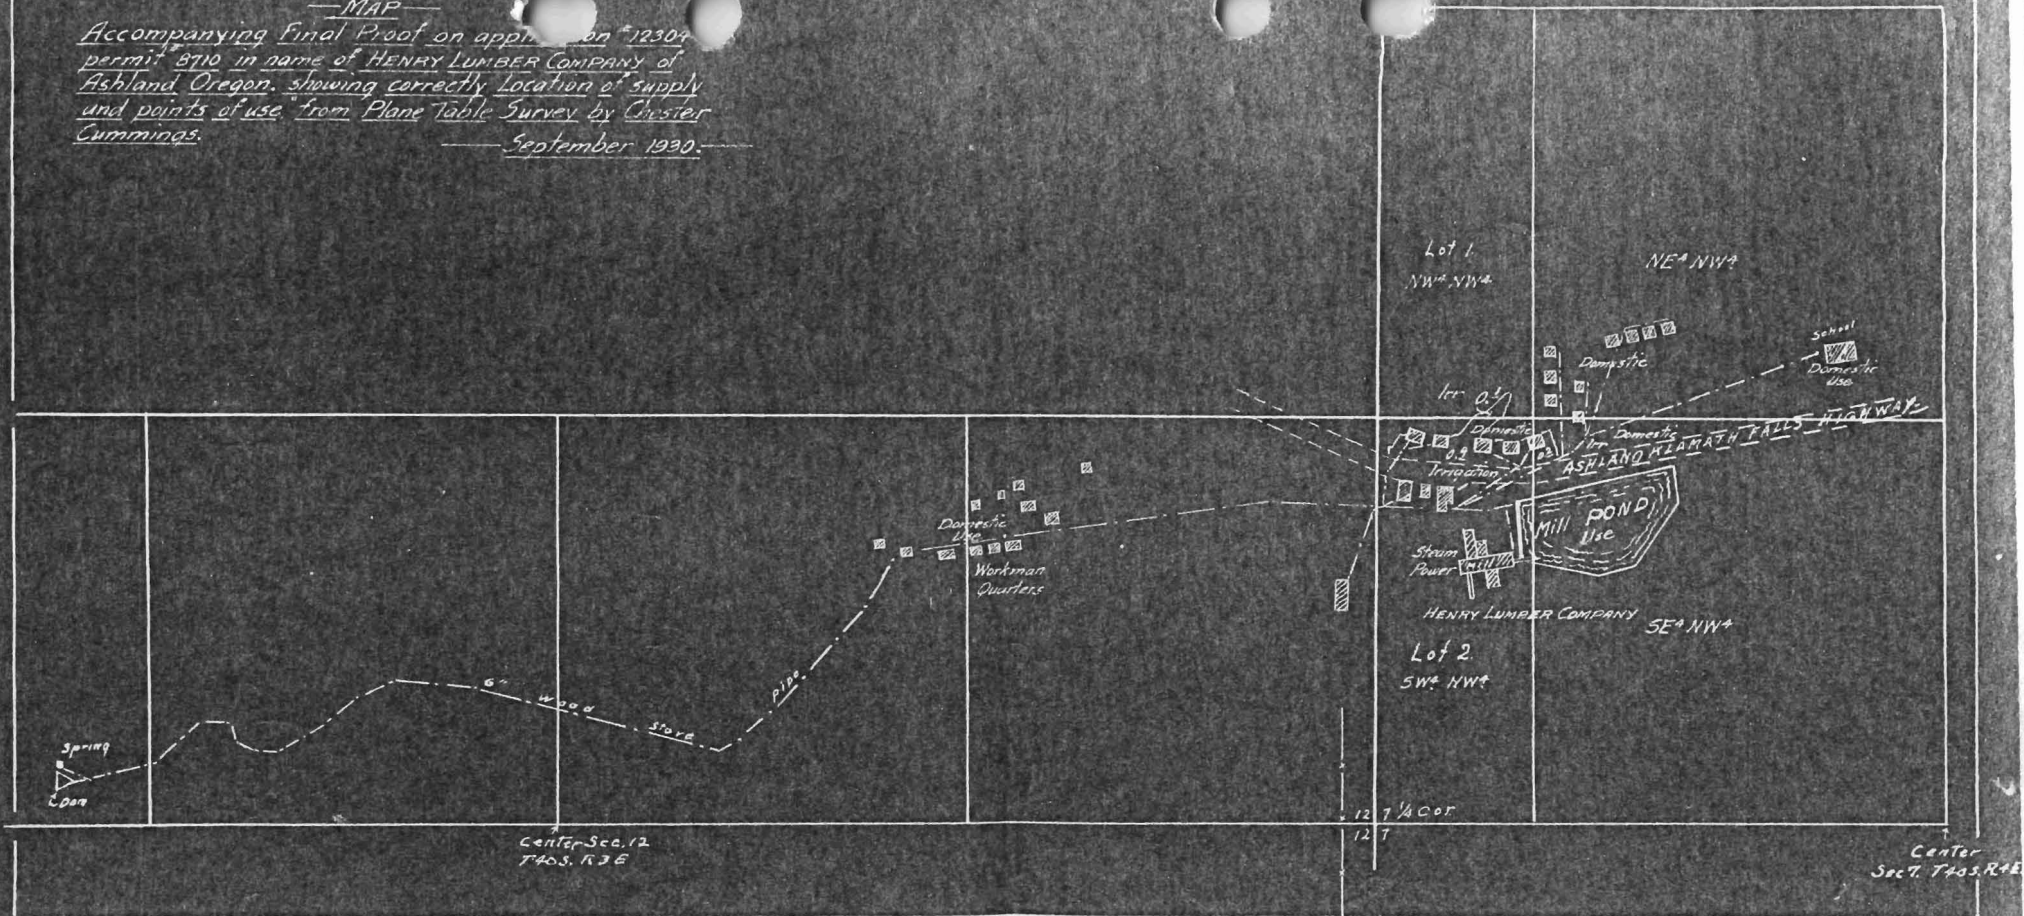

Keene Ck. & Musc.

App. #123048710
 89217