
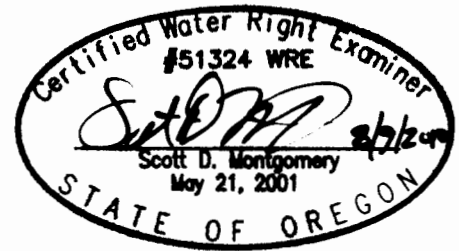


FINAL PROOF MAP

TO TRANSFER RIGHTS AND
CHANGE POINT OF APPROPRIATION
FOR T-10556

JESSE AND SHANNON WARKENTIN

TOWNSHIP 25 SOUTH, RANGE 18 EAST, SECTION 17, W.M.
TAX LOTS: 3400, 3500, 4000, AND 4100

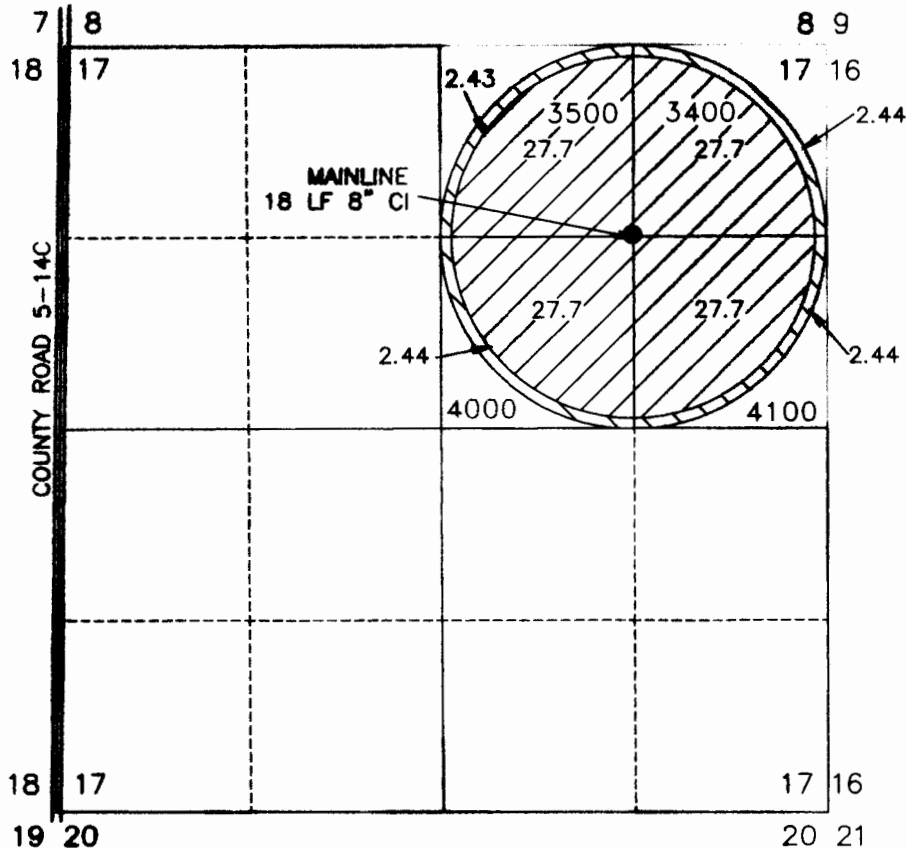


RENEWAL DATE: 12/31/2010

● LAKE 51181

NEW WELL IN THE NE1/4 OF SECTION 17 LOCATED
1320 FEET SOUTH AND 1320 FEET WEST FROM THE
NORTHEAST CORNER OF SECTION 17, TOWNSHIP 25
SOUTH, RANGE 18 EAST, W.M., LAKE COUNTY,
OREGON

NEWLY INSTALLED METER IS APPROXIMATELY 11.0
FEET SOUTH ALONG DELIVERY PIPE FROM WELL

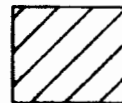

110.8 ACRES FROM G-9121 (CERT.# 52877)
TRANSFERRED, AS SHOWN



9.75 ACRES FROM G-10704 (CERT.# 83518)
TRANSFERRED, AS SHOWN

THIS MAP IS FOR THE PURPOSE OF LOCATING A WATER
RIGHT ONLY AND HAS NO INTENT TO PROVIDE LEGAL
DIMENSIONS OR THE LOCATION OF PROPERTY LINES

PREPARED FOR:

JESSE & SHANNON WARKENTIN
P.O. BOX 842
CHRISTMAS VALLEY, OR 97641

PREPARED BY:



ALL POINTS ENGINEERING AND SURVEYING, INC.
P.O. BOX 767 (CRR) TERREBONNE, OR 97760
(541) 548-5833
www.APEandS.com