


FINAL PROOF MAP

IN THE NAME OF PHILIP OLSON
T-10450


T 5 & 6 S, R 4 W, W.M. Section 33 & 4

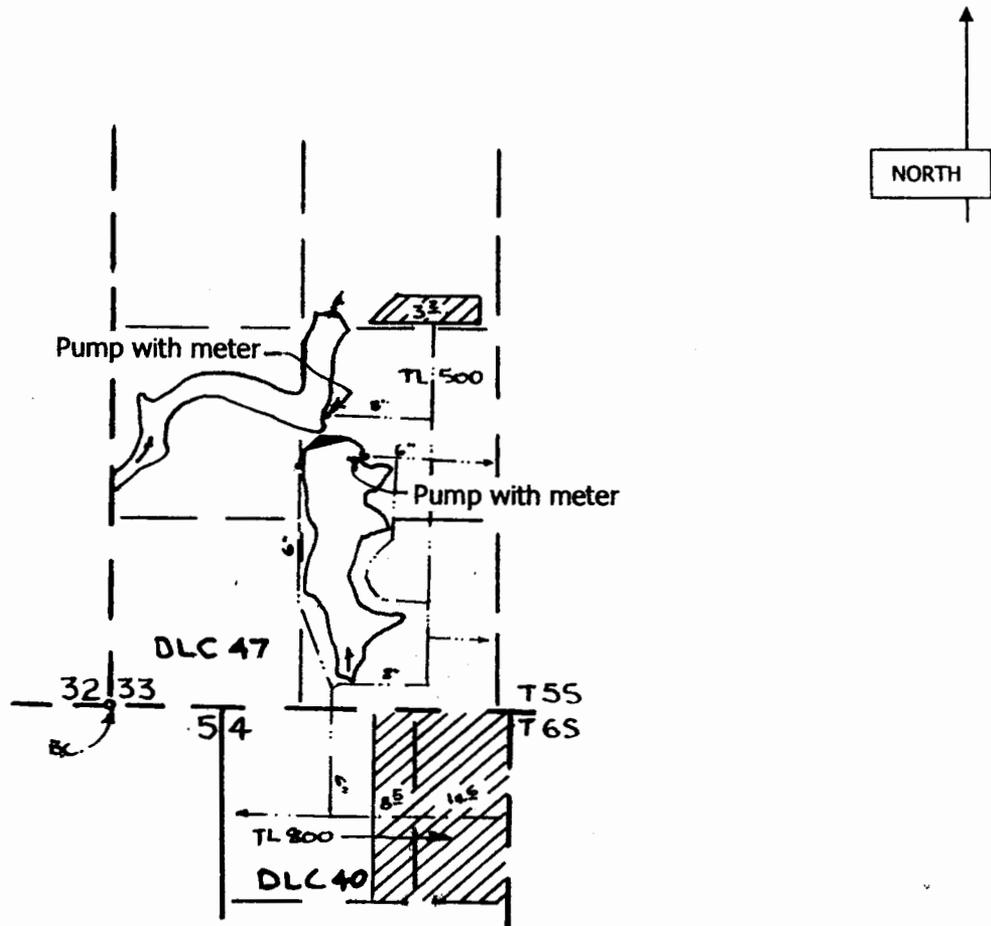

DLC line - - - - -
Section line - - - - -
Pipe line - · - · - ·

DIVERSION POINTS: 2720' N & 1570' E; 1860' N & 1450' E
Both from the SW Corner section 33

Scale 1" = 1320'

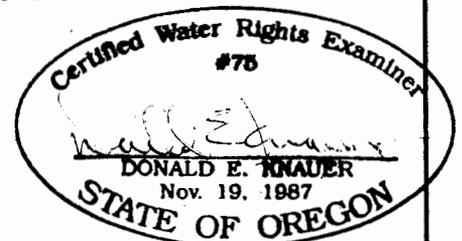

This map is not intended to provide legal dimensions or locations of property ownership lines.

RENEWAL DATE: 6-30-2011