
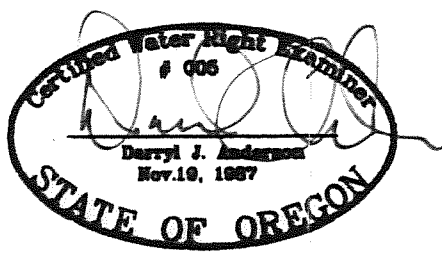


CLAIM OF BENEFICIAL USE MAP

FOR
RICHARD EMERY

SECTIONS 1 & 12, T30S R17E, W.M.
SECTIONS 6 & 7, T30S R18E, W.M.
LAKE COUNTY, OREGON

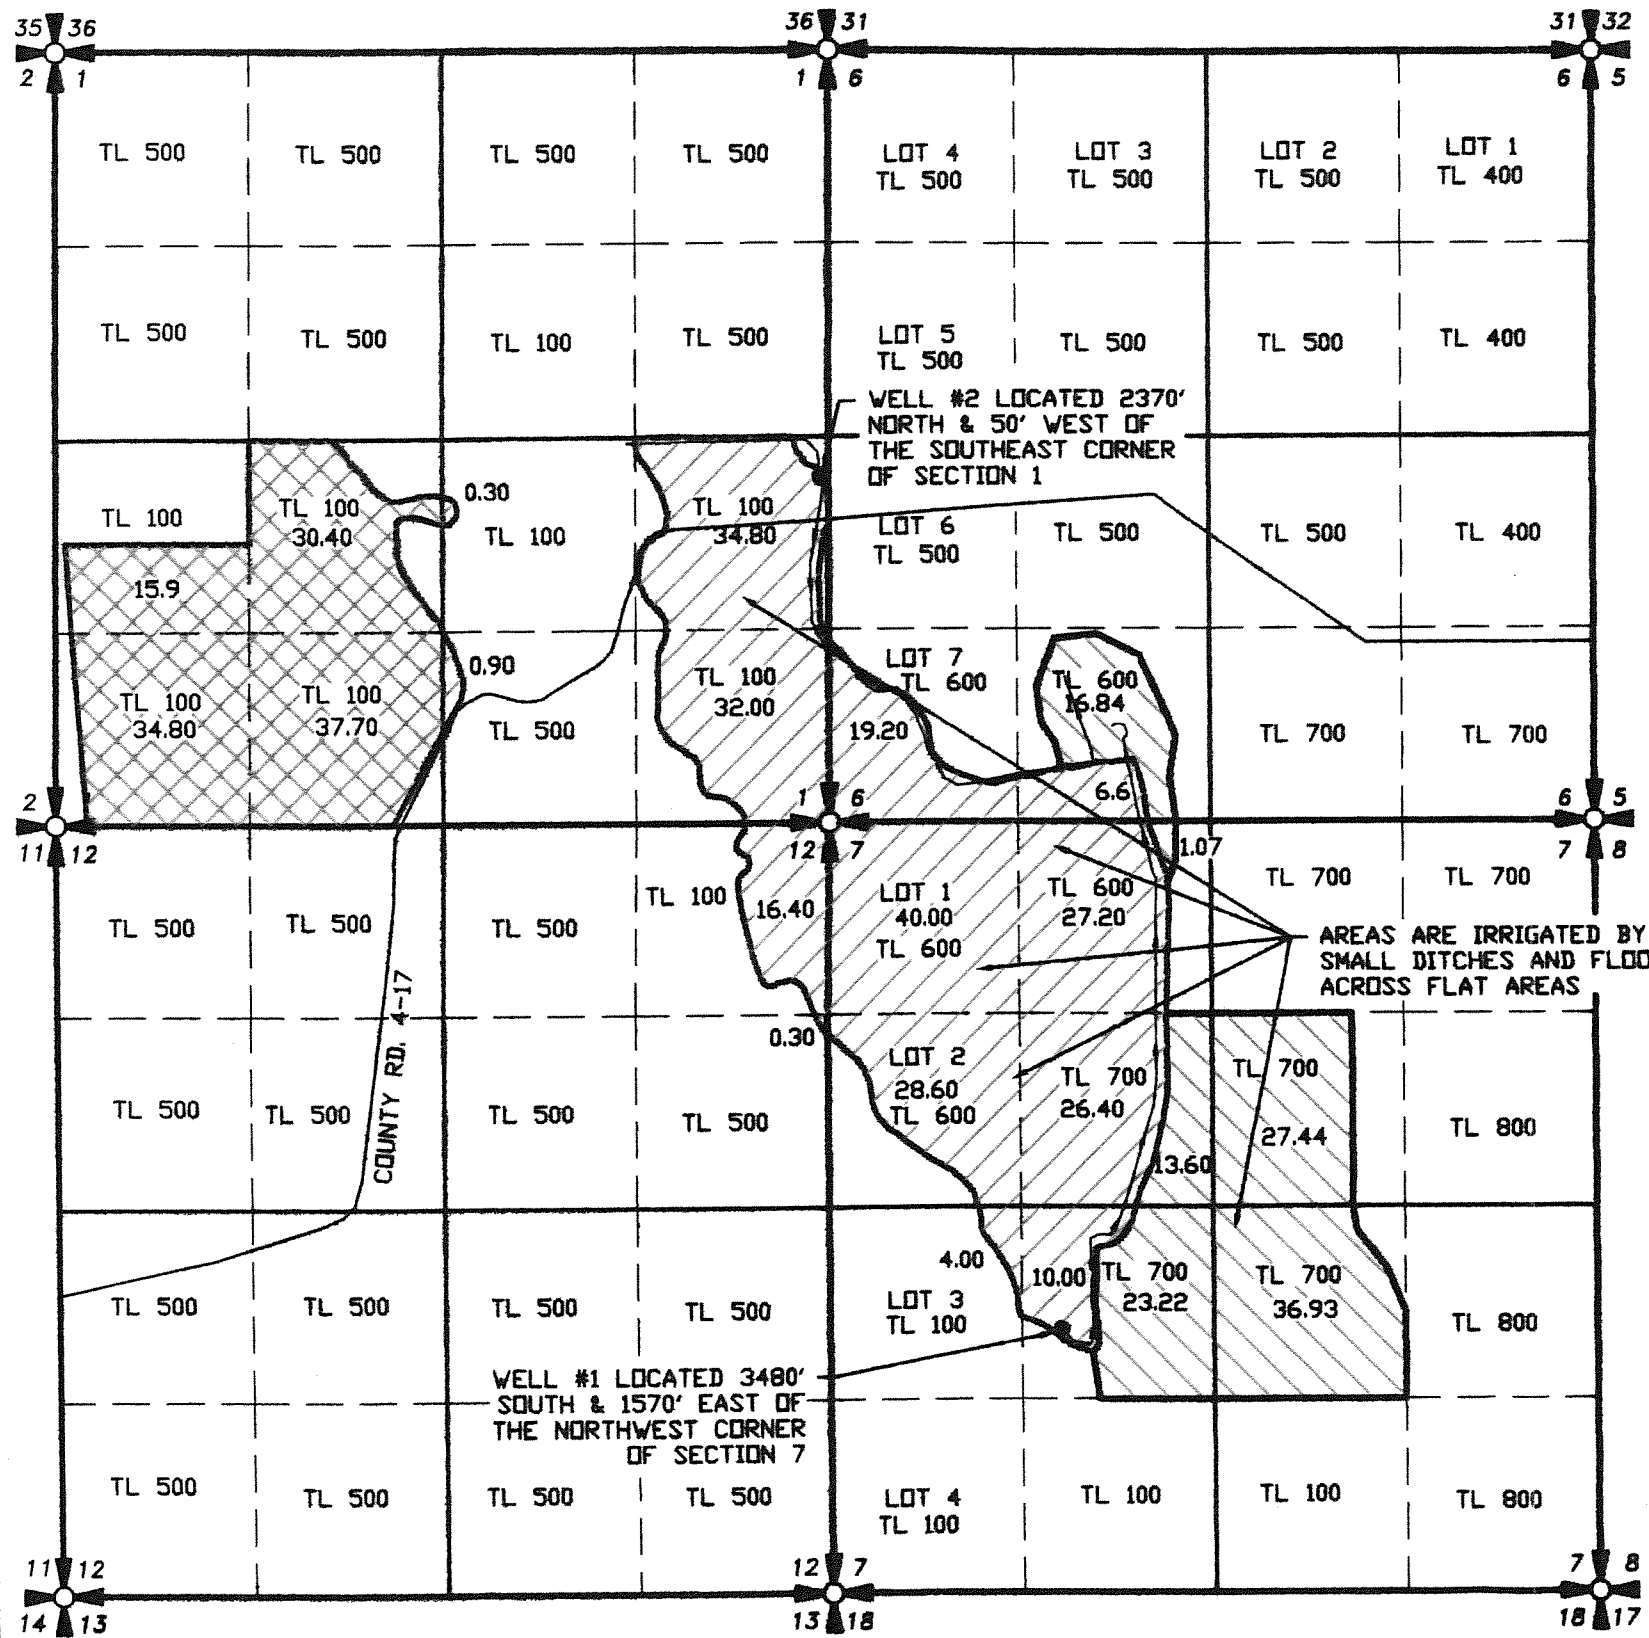

RENEWAL 12/31/13



SCALE: 1"=1320'

LEGEND

- SECTION LINE
- 1/4 SECTION LINE
- 1/16 SECTION LINE
- MAIN LINES - DITCHES
SHOWING FLOW DIRECTION

- CERTIFICATE 86774 - 246.4 ACRES
REMAINING FROM CERTIFICATE 83058
- CERTIFICATE 83058 AREA
TRANSFERRED - 119.1 ACRES
- NEW PLACE OF USE FOR AREA TO
BE TRANSFERRED - 119.1 ACRES

RECEIVED

MAR 1 2 2012

WATER RESOURCES DEPT
SALEM, OREGON

TRANSFER NO. T-11085

NOTE:
PREPARATION OF THIS MAP IS FOR IDENTIFYING PROPOSED
WATER RIGHTS ONLY. IT HAS NO INTENT TO PROVIDE
LOCATIONS OR DIMENSIONS OF PROPERTY BOUNDARIES.

REVISION	BY
11-8-2010	J.E.M.

ANDERSON ENGINEERING
AND SURVEYING, INC.
P.O. BOX 28
LAKEVIEW, OREGON 97630
(541) 947-4407
FAX: 947-2321

FOR:
RICHARD EMERY
P.O. BOX 116
SUMNER LAKE, OR 97640
541-480-3045

MAP TO ACCOMPANY WATER
RIGHT TRANSFER APPLICATION

DATE:	04-07-10
SCALE:	1"=1320'
DWG. BY:	R.C.
JOB:	2011-084
FILE:	2011-084
SHEET:	1 OF 1

COBU MAP # 0668
folder V