



T 23 S, R 31 E, WM
R 32 E, WM

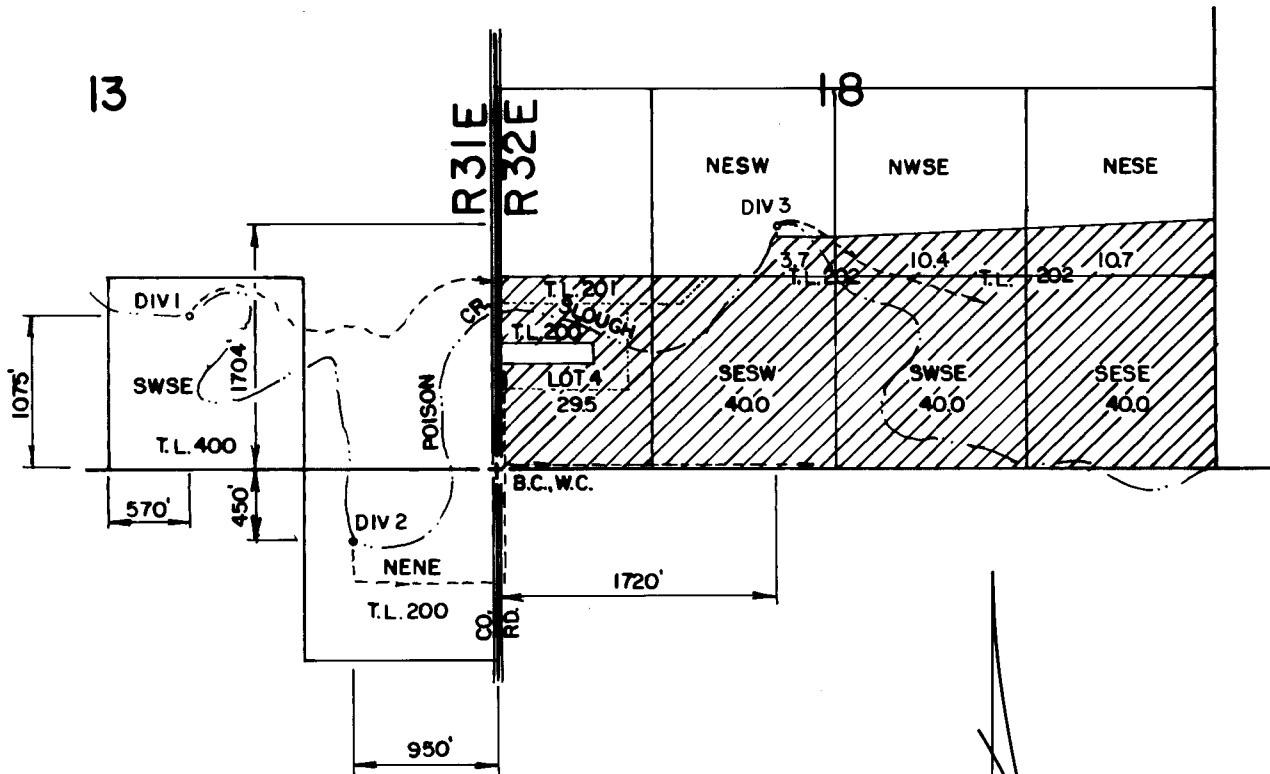

24

THE PURPOSE OF THIS MAP IS TO
IDENTIFY THE LOCATION OF THE

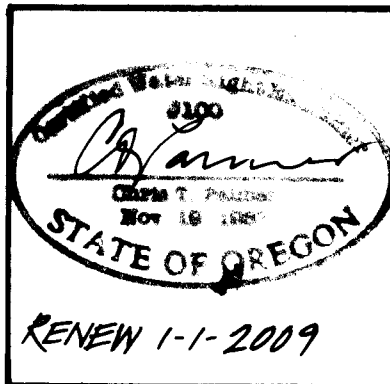

FINAL PROOF SURVEY

UNDER
T-9737

IN THE NAME OF
STEVE RICKMAN

Scale: 4" = 1 MILE

Date: DEC. 2008

Job: 2188-08

Dsn:

Drm: CHRIS

Ckd:



M.A. PALMER & SONS, INC.
ENGINEERING & SURVEYING
711 Ponderosa Village • Box 61
Burns, Oregon 97720

Sht. No.

of

1