


T. 8 & 9 S., R. 18 E., W. M.

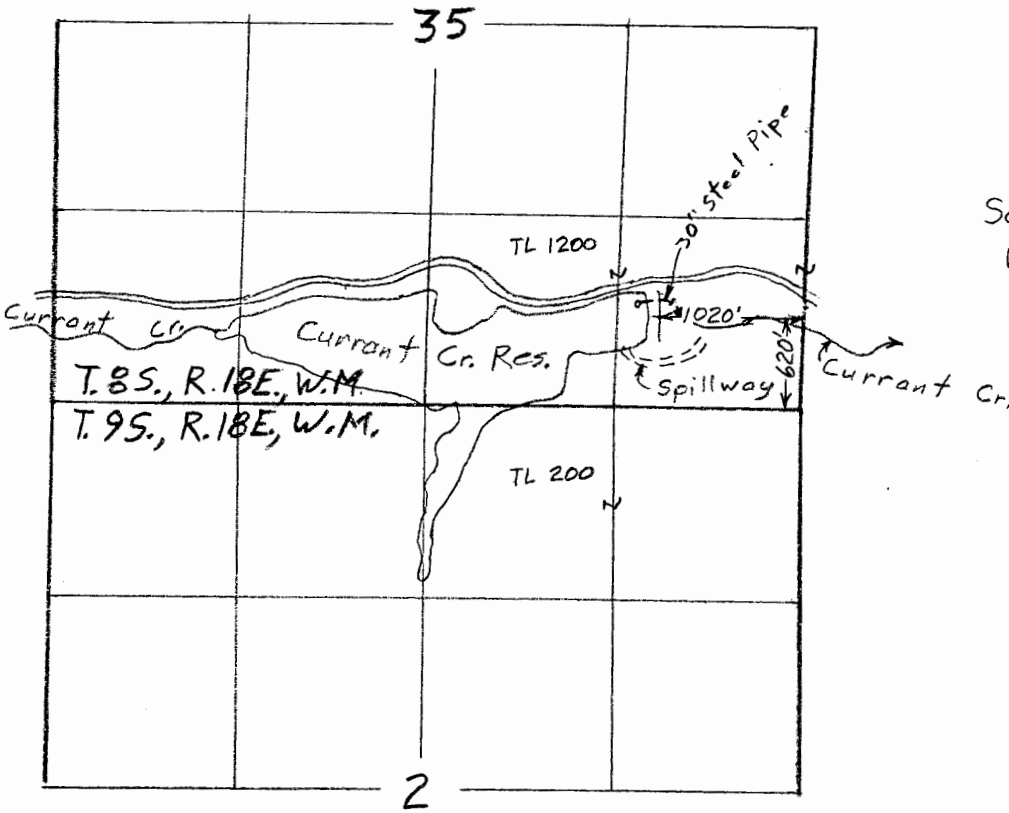

Scale 1" = 1320'  
(4" = 1 mile)

RECEIVED BY OWRC

FEB 24 2014

SALEM, OR

Surveyed Aug 6, 2013

T- 7886

Claim of Beneficial Use Map  
for  
Washington Family Ranch  
(Younglife Camp)



This map is for the purpose of  
locating a water right only  
and has no intent to provide  
legal dimensions or the location  
of property lines.

**ESTES SURVEYS, LLC**  
 PO Box 47519      60382 Arnold Rd  
 Salem, OR 97305-7519      Bend, OR 97707  
 (503) 565-7595      (541) 338-1111

Amended Feb 18, 2014