


# FINAL PROOF SURVEY MAP


## T 5 S R 1 W sections 21 & 22

**RECORDED**  
**SEP 15 2015**  
**REGISTERED SURVEYOR**  
**CLARA CRONIN**

Prepared for: Fessler Family, LLC  
transfer T-6992

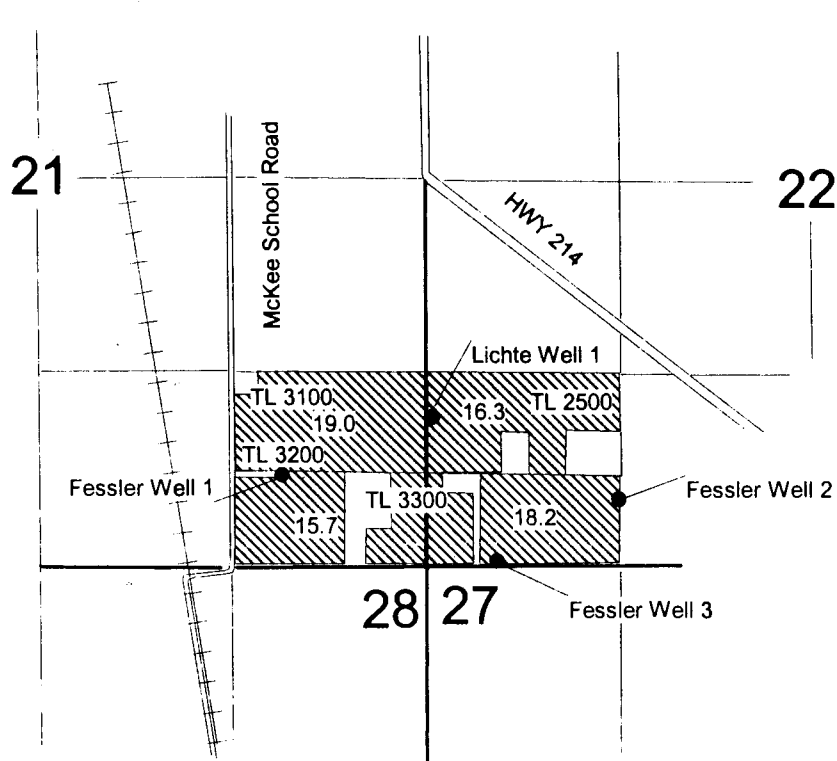

Lichte Well 1: 1040' N & 20' E  
Fessler Well 1: 630' N & 1000' W  
Fessler Well 2: 550' N & 1290' E  
Fessler Well 3: 20' N & 460' E  
all from the SW corner Section 22  
(All wells have measuring devices at well site.)

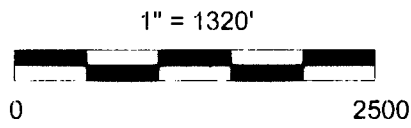

This map is for water right purposes only.

