


FINAL PROOF SURVEY MAP

T 6 S R 1 W, W.M.
Portions of sections 5,6,7,8

Prepared for Golden Valley Farms
Transfer # T-7948

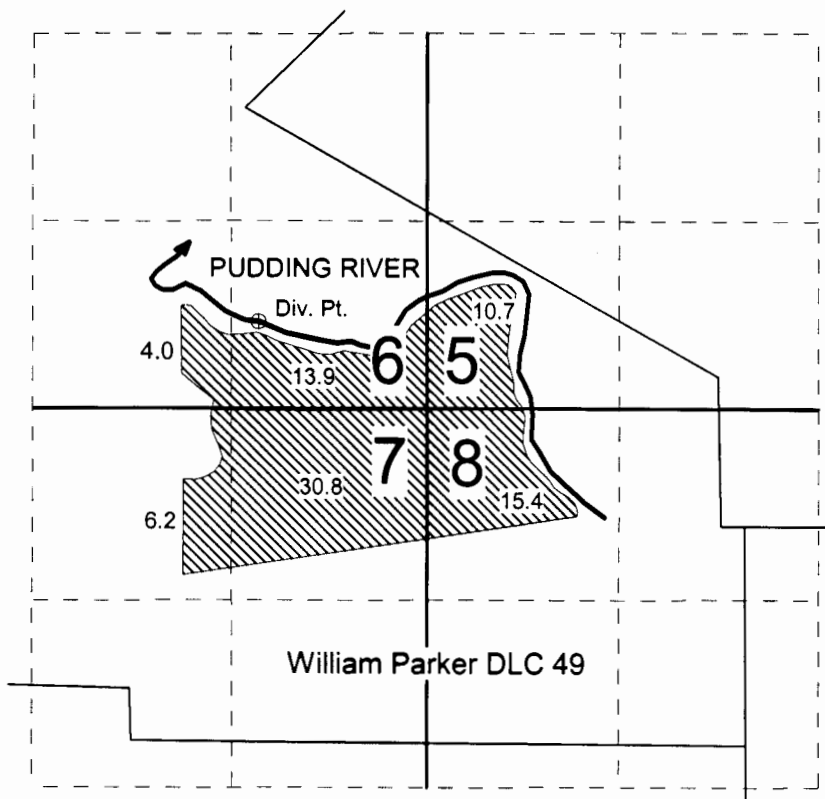

Diversion Point: 610' N. & 1150' W. from the SE corner section 6

This map is for water
right purposes only.

Scale 4" = 5280'

