


T.22S., R. 9E., W.M.

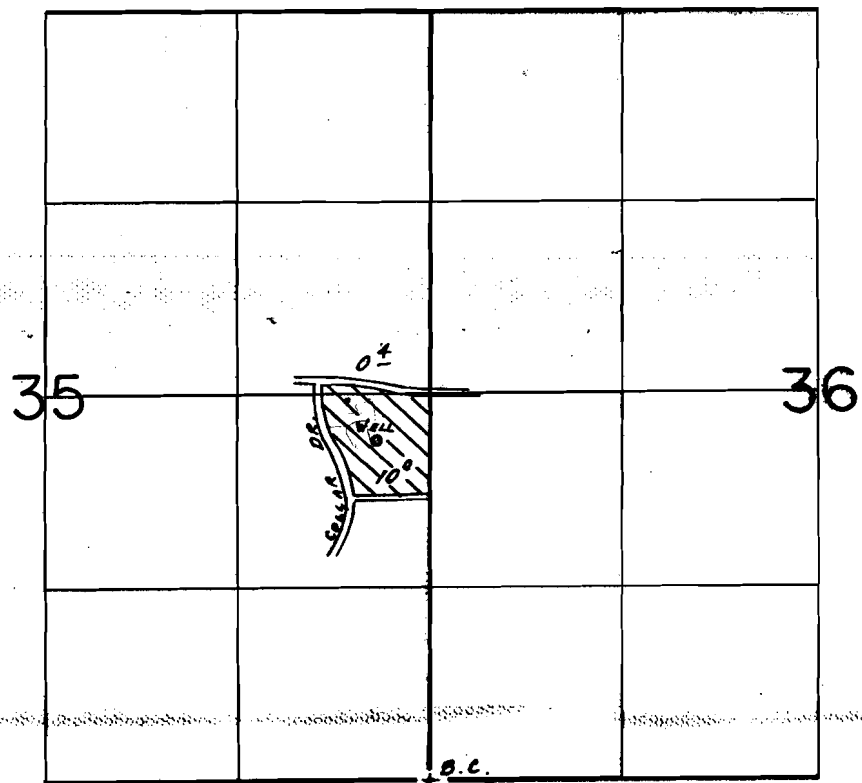

WELL LOC.: 2340' N. & 370' W. FROM SE COR. SEC. 35

SCALE: 1" = 1320'

**FINAL PROOF SURVEY**  
UNDER

Application No. G-1082 Permit No. G-10279...  
IN NAME OF

cert. 64253

.....TIMOTHY D. JUDD.....

Surveyed July 13, 1988, by B.W. BISHOP.....