
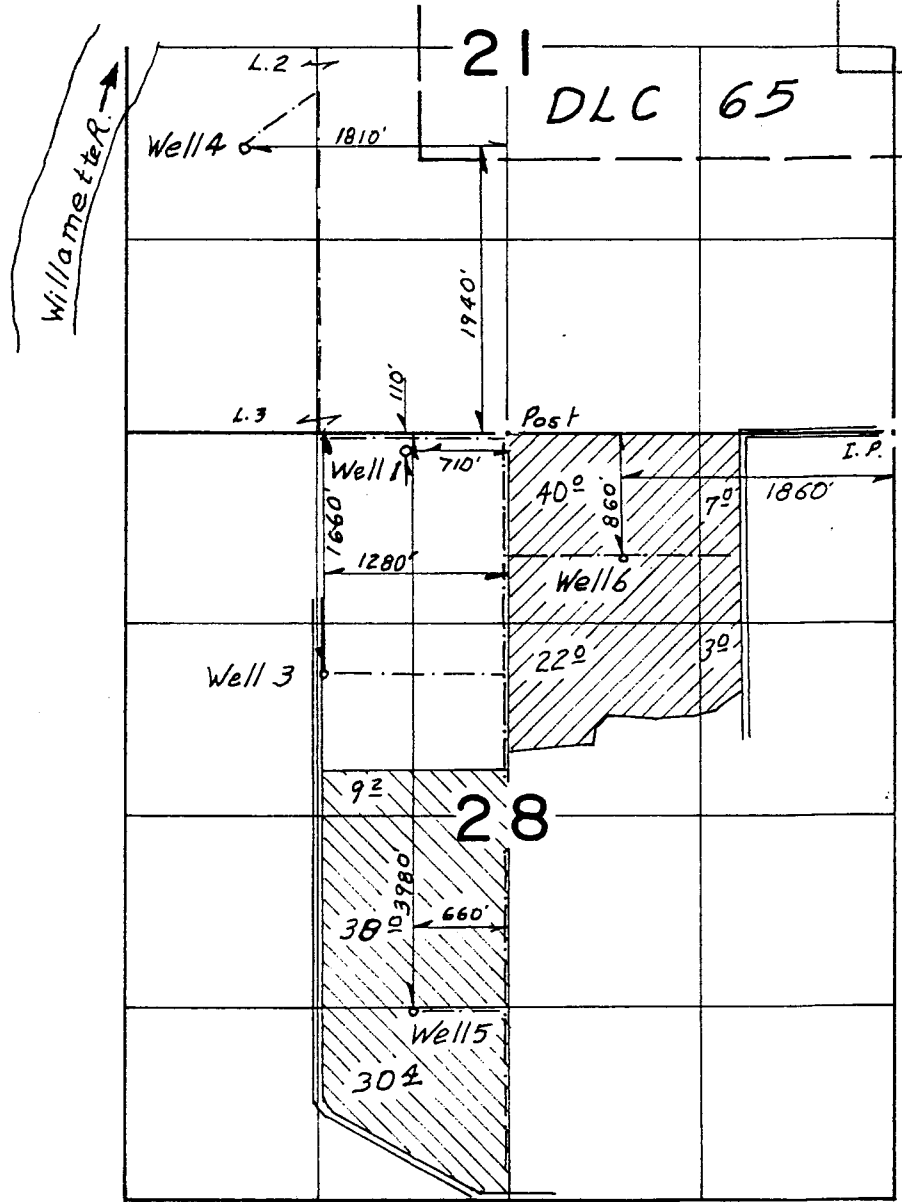


T.6S. R.3W. W.M.

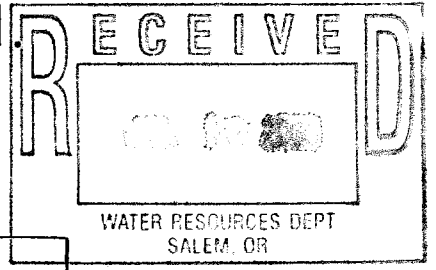


Scale 4" = 1 Mi.

FINAL PROOF SURVEY UNDER

Transfer No. T-7019 Application No. Permit No.

IN NAME OF MILLER FOREST, INC.

Surveyed March 22, 2000 by

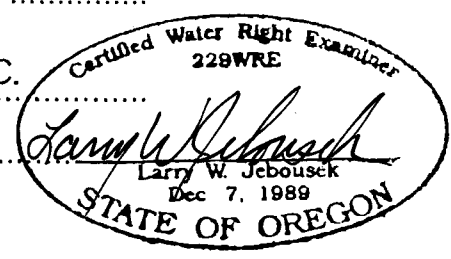

THIS MAP WAS PREPARED FOR THE PURPOSE OF IDENTIFYING THE LOCATION OF A WATER RIGHT ONLY AND IS NOT INTENDED TO PROVIDE LEGAL DIMENSIONS OR LOCATION OF PROPERTY OWNERSHIP LINES.