


**CLAIM OF BENEFICIAL USE MAP**  
**SW 1/4 Section 34, T.25S. R.14E., W.M.**  
*Lake County, Oregon*

*Kenneth V. and Kathleen G. Kruse*  
**T-8381**



**SCALE**  
**1" = 1320'**


Well is located N44°50'45"W a distance of 1855.28' from the S 1/4 Corner Section 34

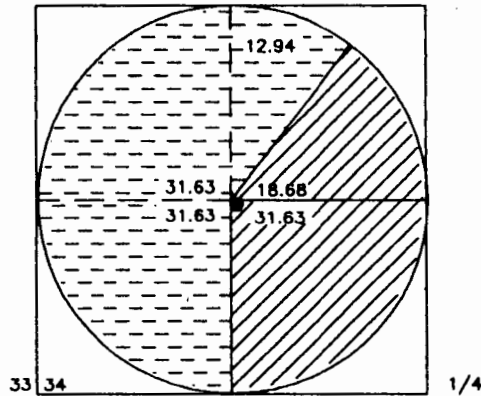

50.31 acres transferred from  
 Permit G-361 Certificate 76226



76.20 acres transferred from  
 Permit G-5497 Certificate 52629

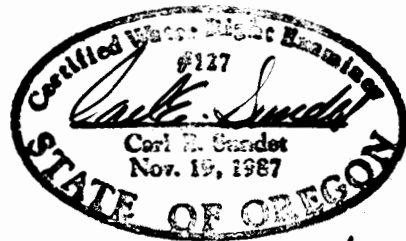

*Renews 6/30/04*

Surveyed by: Sundet and Associates  
 P.O. Box 1228  
 Lakeview, OR 97630  
 (541) 947-3293

Drawing #16403                      January 2003

This map is for the purpose of identifying the location of the water right only and is not intended to provide legal dimensions or property ownership lines.