


CLAIM OF BENEFICIAL USE MAP
SW 1/4 Section 34, T.25S. R.14E., W.M.
Lake County, Oregon

Kenneth V. and Kathleen G. Kruse
T-8381



SCALE
1" = 1320'

Well is located N44°50'45"W a distance of 1855.28' from the S 1/4 Corner Section 34

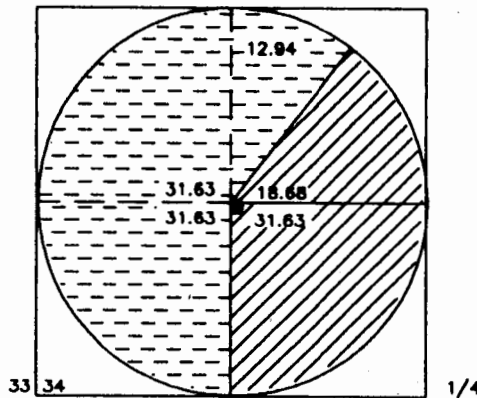

50.31 acres transferred from
 Permit G-361 Certificate 76226



76.20 acres transferred from
 Permit G-5497 Certificate 52629



Renews 6/30/04

Surveyed by: Sundet and Associates
 P.O. Box 1228
 Lakeview, OR 97630
 (541) 947-3293
 Drawing #16403 January 2003

This map is for the purpose of identifying the location of the water right only and is not intended to provide legal dimensions or property ownership lines.