


*Superseded
2-25-14*

T33S & T34S R5W

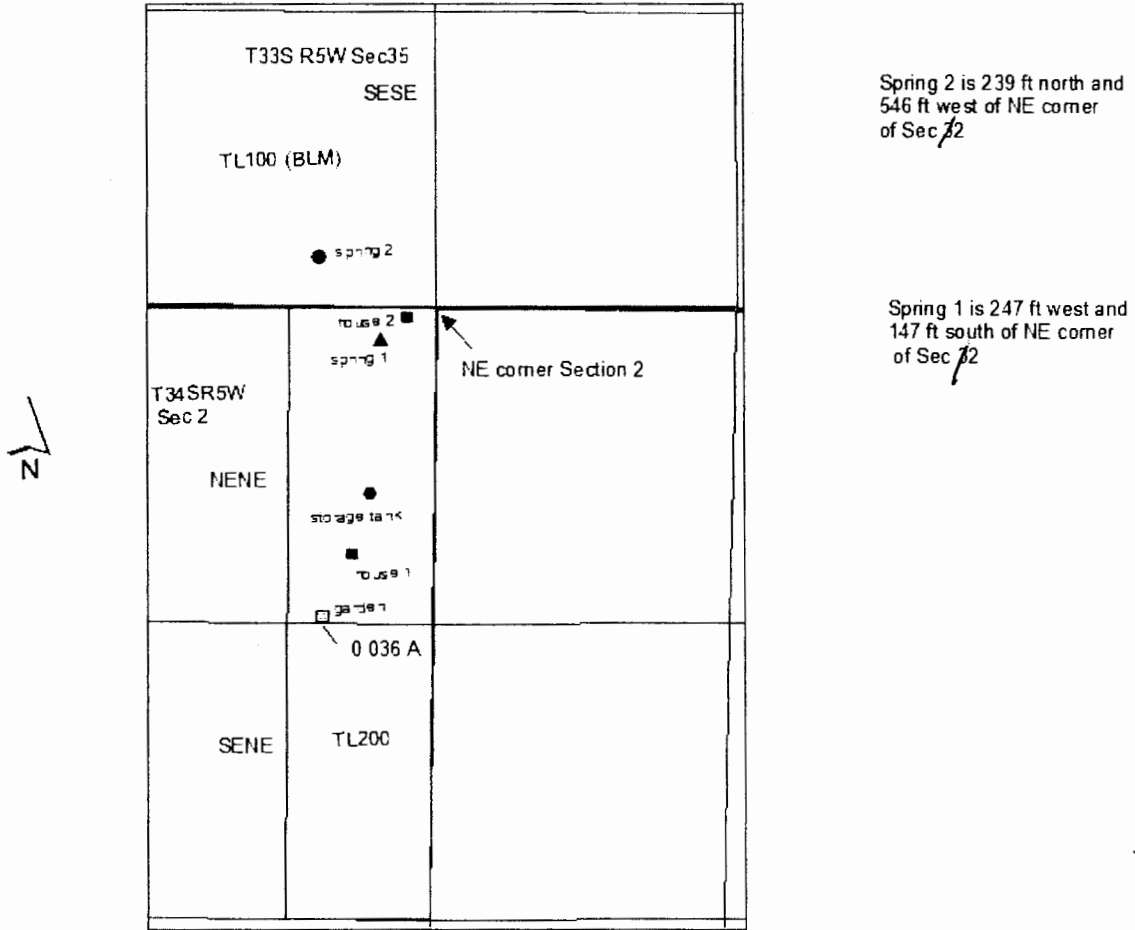

1 inch = 660 feet

**FINAL PROOF SURVEY
UNDER
Application No. 56885 Permit No.42661
IN NAME OF
Marvin C. Turley**

K Smith December 14, 2011

DC 2/7/14

RECEIVED BY OWRD

JAN 06 2014

SALEM, OR