


T. 6S. R. 2W. W.M.

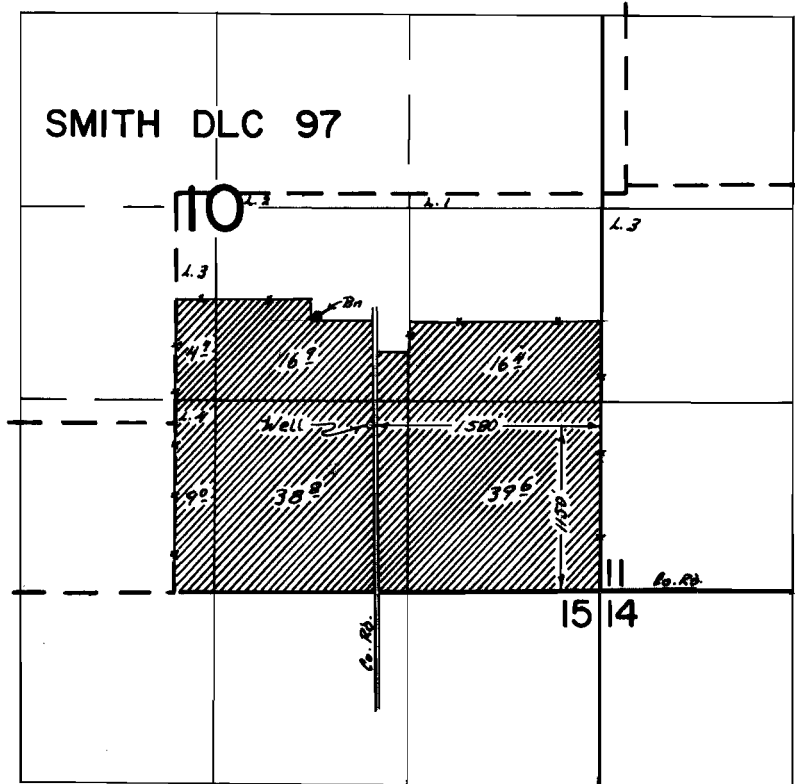

FINAL PROOF SURVEY UNDER

Application No. E-5719 Permit No. G-4644
IN NAME OF

WILLIAM & MARY LOU HOLOBOFF

Surveyed May 18 1972, by R. G. Mucken