



# FINAL PROOF MAP IN THE NAME OF

THOMAS H. DeARMOND  
 Appl.: G-16608, Permit: G-16181  
 T 4 S, R 1 W, W.M


RECEIVED

JAN 3 2013

PLANNING & ZONING DEPT  
 500 N. GASTRAN

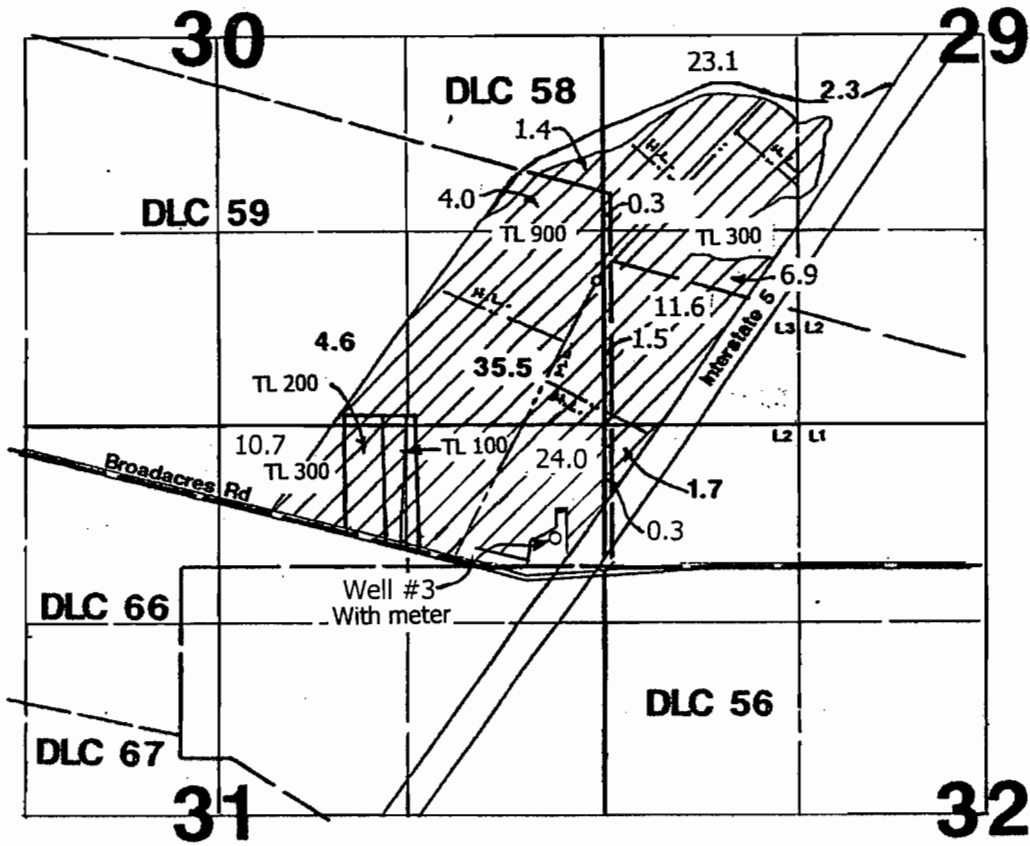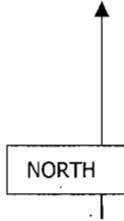

- Section line ———
- 1/4 1/4 line ———
- DLC line - - - - -
- Pipe line - · - · - ·
- Tax Lot line ———

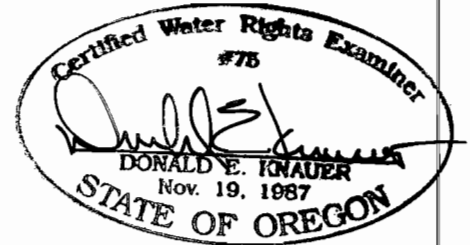

RENEWAL DATE: 6-30-2013

Well #3 with meter: 220' N & 400' W from the SE corner of DLC 59  
 Scale 1" = 1320'

This map is not intended to provide legal dimensions or locations of property ownership lines.