

# CLAIM OF BENEFICIAL USE


TRANSFER 9447

TRANSFER 9448

MAP 2 OF 2 USE AND PLACE OF USE

TOWNSHIP 25 SOUTH, RANGE 7 WEST, W.M.

DOUGLAS COUNTY OREGON

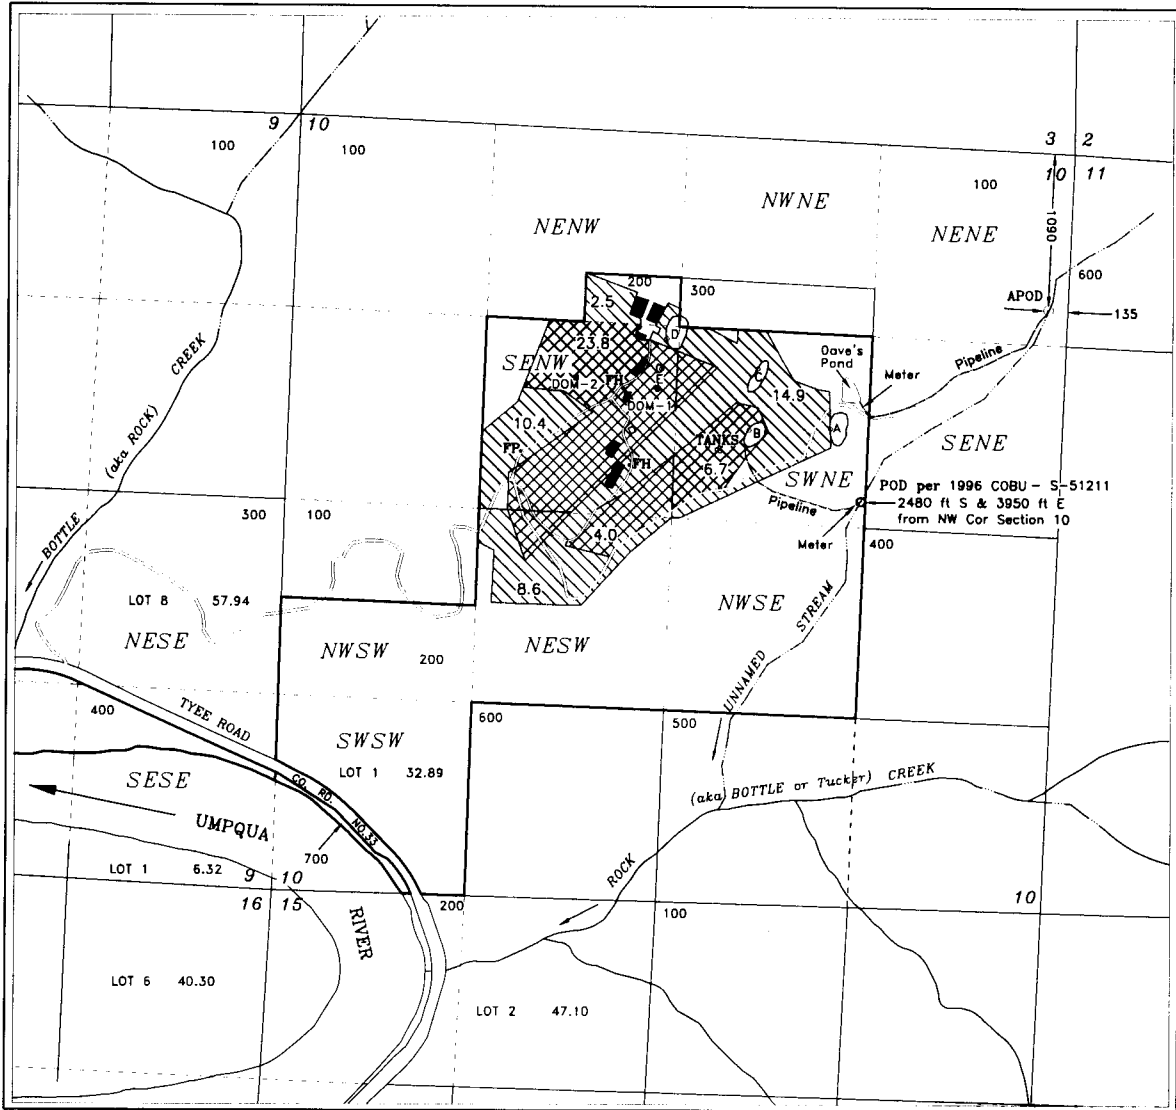

KIRPAL LIGHT SATSANG, INC.

## USE OF WATER

T-9448



34.5 Acres - Irrigation  
Supplemented by T-9447

Maintenance of a Fire Protection System (Tanks & Reservoirs)

FP - Fire Plug

FH - Fire Hydrant

T-9447




36.4 Acres - Irrigation



34.5 Acres - Supplemental Irrigation  
Supplemental to T-9448


Domestic use in 2 dwellings

This map is not intended to provide legal dimensions or locations of property ownership lines

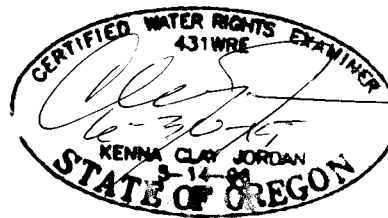

Scale

1 inch = 1320 feet

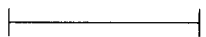

JORDAN ENGINEERING  
460 JORDAN LANE  
ROSEBURG, OR 97471  
(541) 673-1931

Base Map: Douglas County GIS  
2005 FSA Aerial Photos  
USGS Quadrangle

Revised 12/19/2013 n.e.d.