T. 8S., R. 39E., W. M.

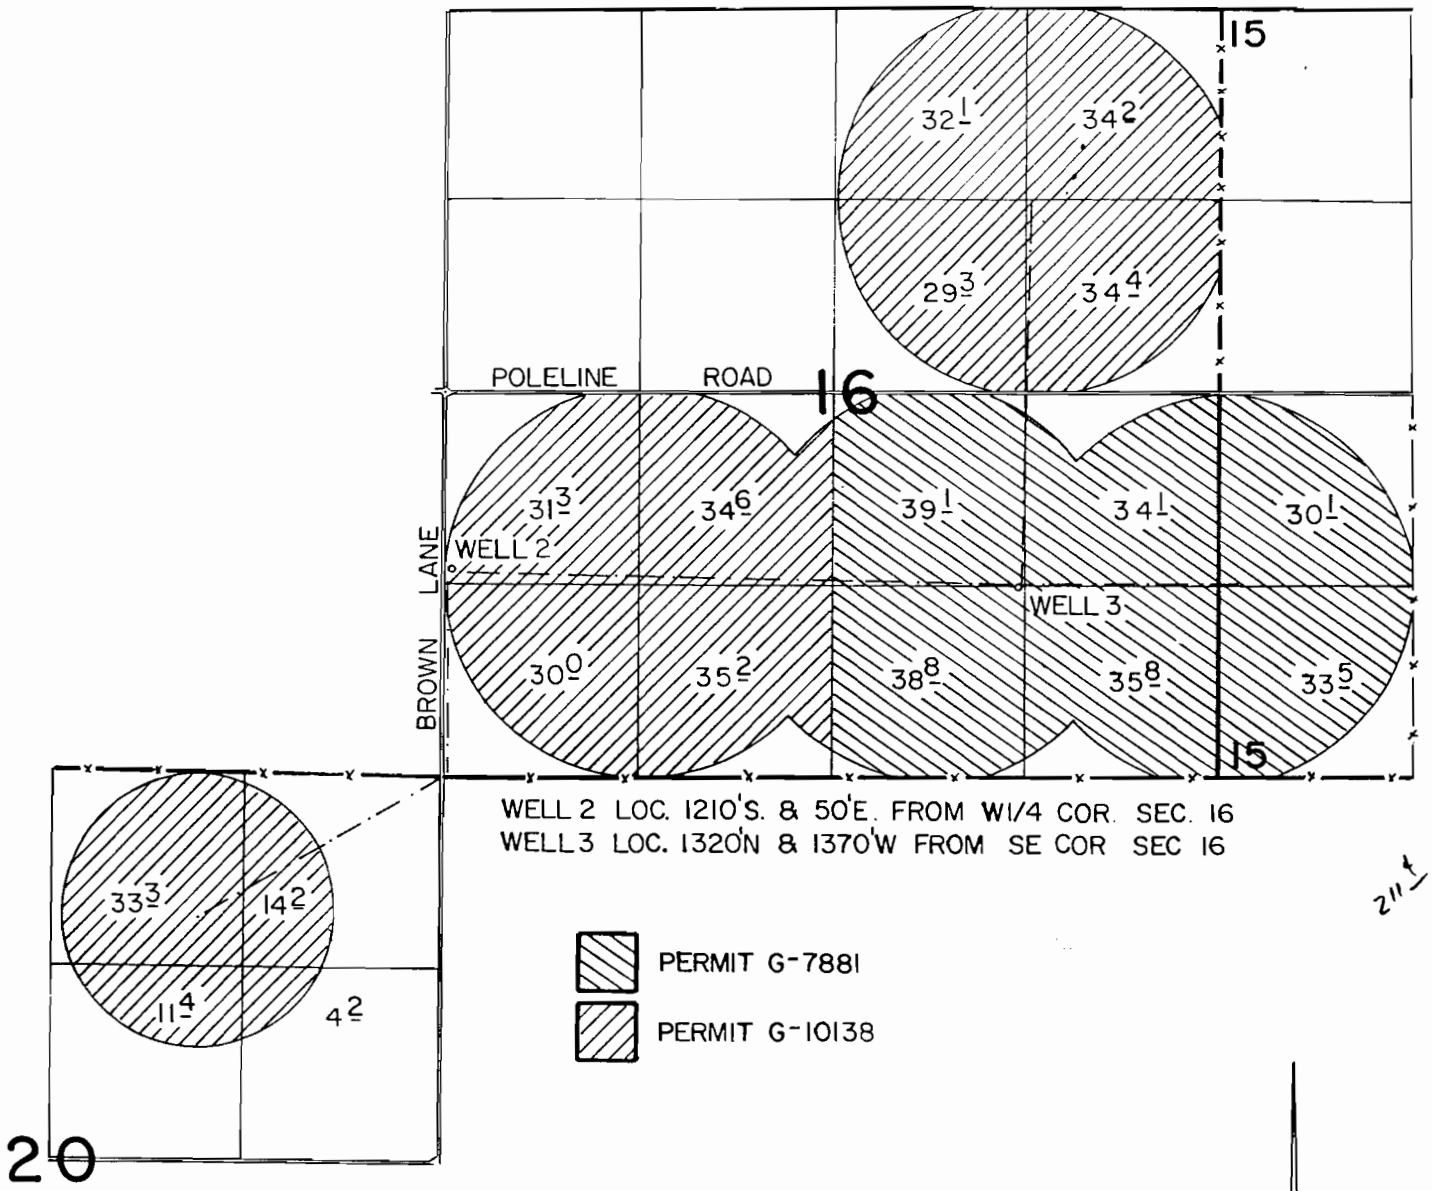

WELL 2 LOC. 1210'S. & 50'E. FROM W1/4 COR. SEC. 16
WELL 3 LOC. 1320'N & 1370'W FROM SE COR SEC 16

211 ±

FINAL PROOF SURVEY

UNDER

Application No. G-8532 G-10928 Permit No. G-7881 G-10138

IN NAME OF

JIM & DAVE BLATCHFORD

Surveyed March 28 1983, by V.L. Church
July 16 84

88L, 88R
PTS-1984 PD

VLC