


**Claim of Beneficial Use in name
of Bobby Morrison, T-9979 &
Wadean Holcomb, T-9980**

SEPT., 2009



SCALE 1" = 1320'


T. 9S., R. 45E., W.M.

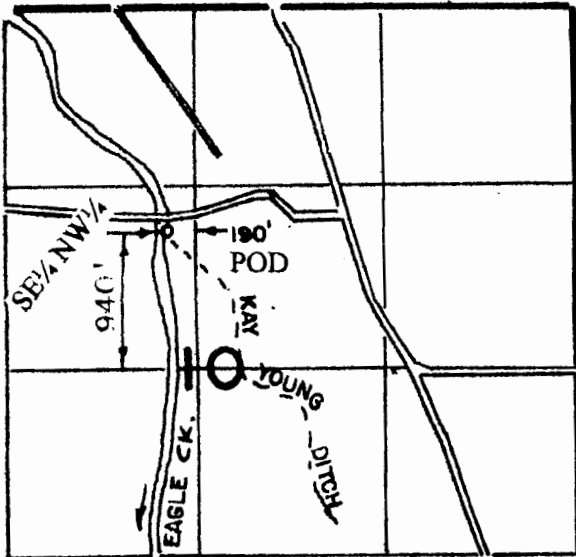

LEGEND

- T-9980
- T-9979

This map is for the purpose of identifying the water right location only and is not intended to provide legal dimensions or location of property ownership lines.

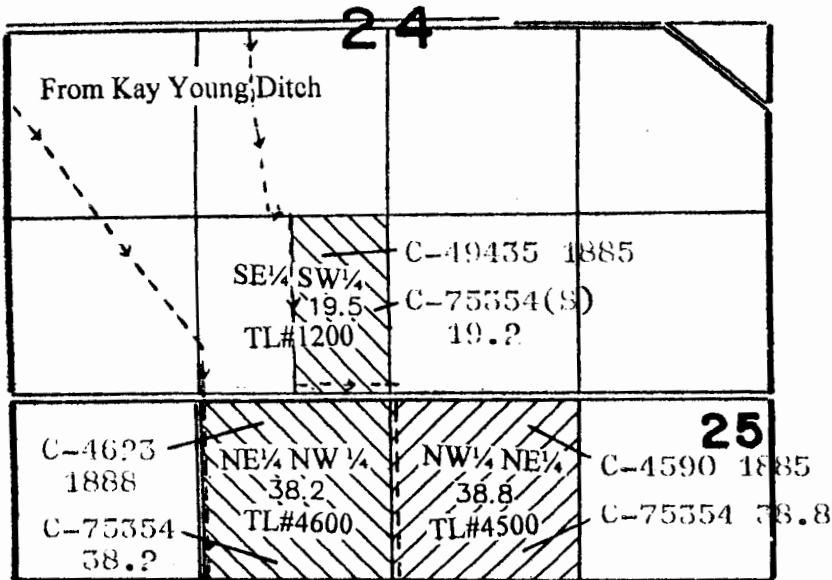

T. 9S., R. 45E., W.M.

RECEIVED
OCT 05 2009
WATER RESOURCES DEPT
SALEM, OREGON

