


**Claim of Beneficial Use in name  
of Bobby Morrison, T-9979 &  
Wadean Holcomb, T-9980**

SEPT., 2009



SCALE 1" = 1320'


**T. 9S., R. 45E., W.M.**

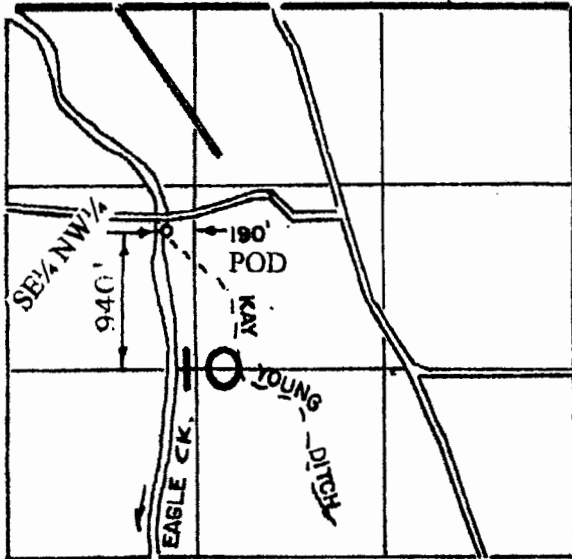

**LEGEND**

- T-9980
- T-9979

This map is for the purpose of identifying the water right location only and is not intended to provide legal dimensions or location of property ownership lines.

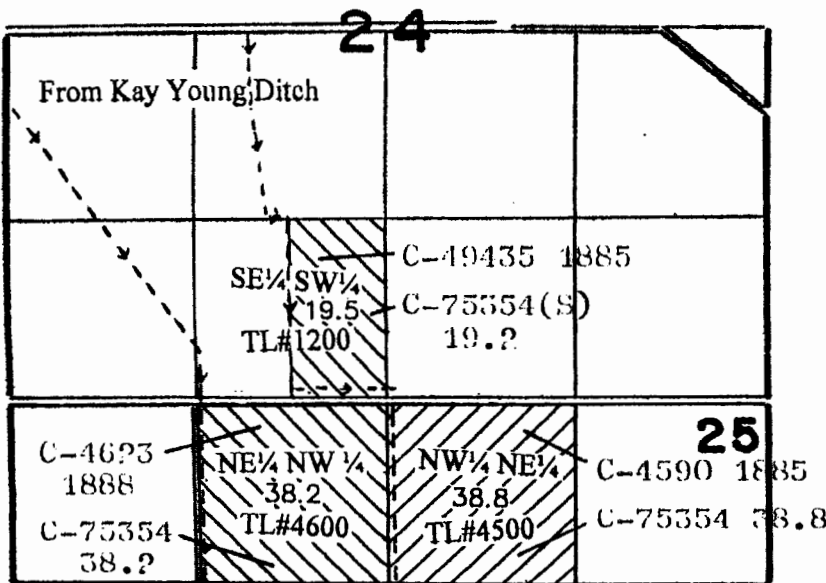

**T. 9S., R. 45E., W.M.**

**RECEIVED**  
OCT 05 2009  
WATER RESOURCES DEPT  
SALEM, OREGON

