T. 4, 5, and 6 S, R. 3 W. W.M.

RECEIVED
MAY 03 2013
WATER RESOURCES DEPT
SALEM, OREGON

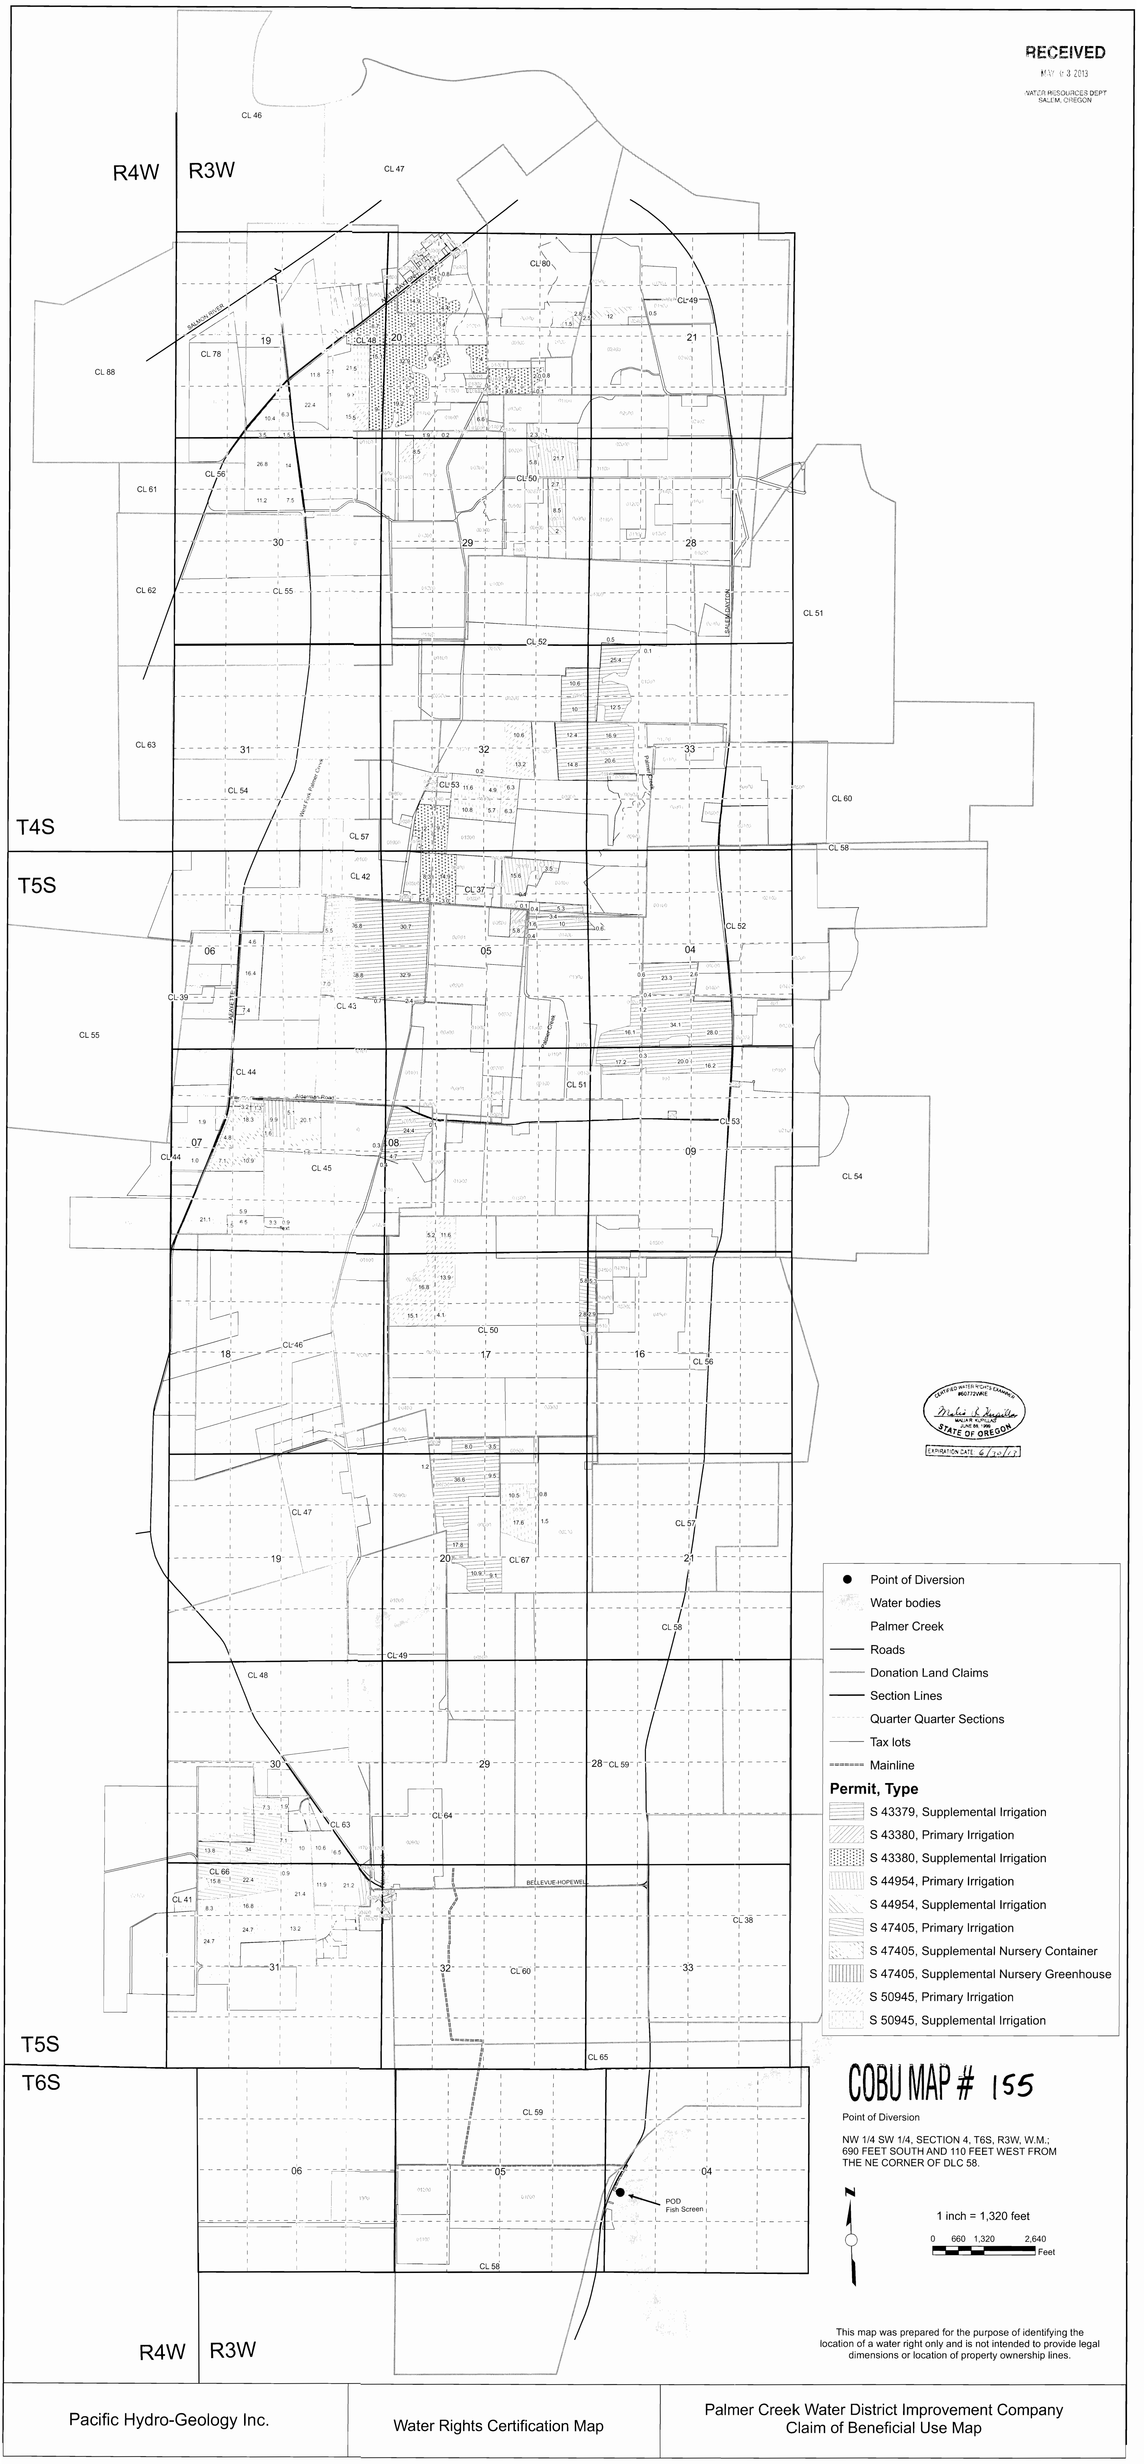

CERTIFIED WATER RIGHTS EXAMINER
MOTTGWE
WILLIE KUYLLE
STATE OF OREGON
EXPIRATION DATE 6/30/17

COBU MAP # 155

Point of Diversion

NW 1/4 SW 1/4, SECTION 4, T6S, R3W, W.M.;
690 FEET SOUTH AND 110 FEET WEST FROM
THE NE CORNER OF DLC 58.

This map was prepared for the purpose of identifying the location of a water right only and is not intended to provide legal dimensions or location of property ownership lines.

Pacific Hydro-Geology Inc.	Water Rights Certification Map	Palmer Creek Water District Improvement Company Claim of Beneficial Use Map