


FINAL PROOF MAP

TO TRANSFER RIGHTS AND
ADD A POINT OF APPROPRIATION
FOR T-11236
PERNOLL RANCH, LLC

TOWNSHIP 29 SOUTH, RANGE 16 EAST, SECTION 9 & 16, W.M.
TAX LOTS: 500 AND 600

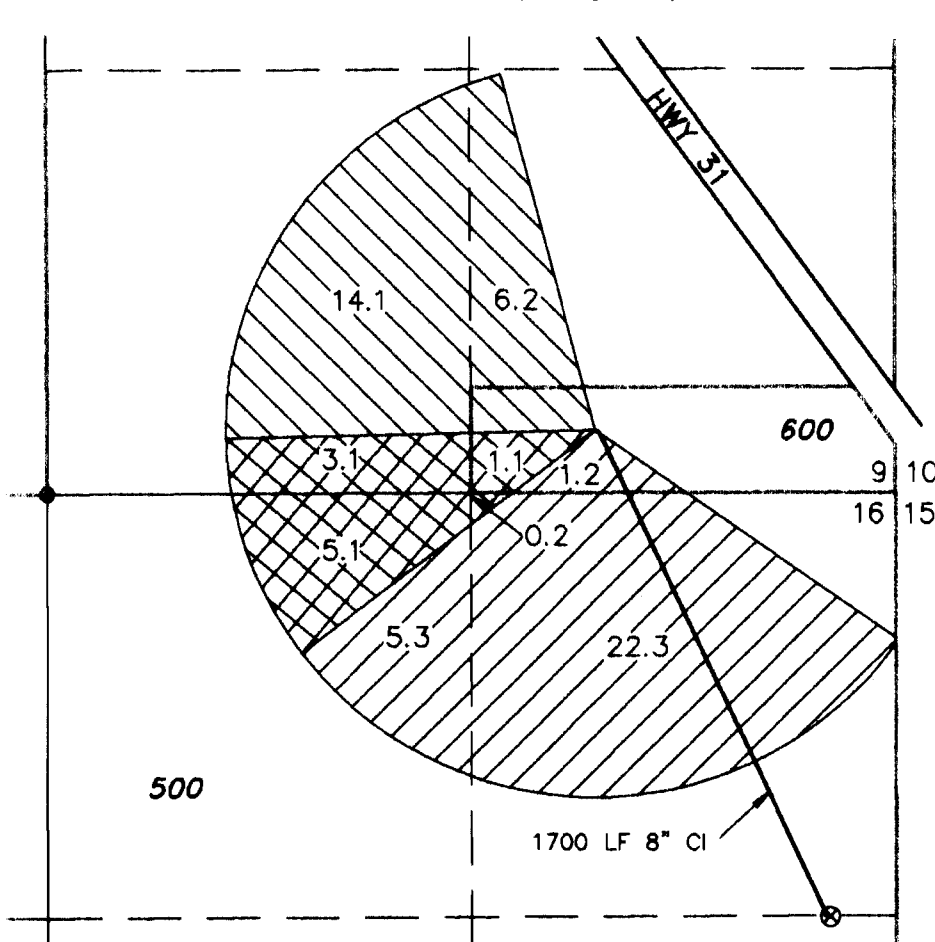

SCALE: 1 INCH = 600 FEET

RECEIVED

NOV 13 2011

WATER RESOURCES DEPT
SALEM, OREGON

◆ SURVEY MONUMENT FOUND
AND TIED




28.8 ACRES WATER RIGHTS
FROM CERTIFICATE #30784
(G-1888), AS SHOWN.



9.5 ACRES WATER RIGHTS
FROM CERTIFICATE #38087
(G-4283), AS SHOWN.



20.3 ACRES WATER RIGHTS
FROM CERTIFICATE #81487
(G-8788), AS SHOWN.

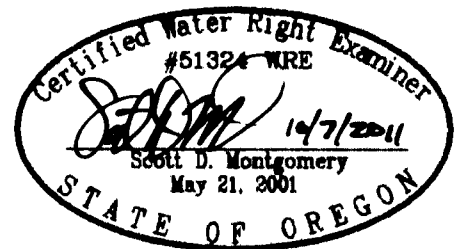

RENEWAL DATE: 12/31/2012

⊗ **LAKE 1443**

EXISTING WELL IN THE NE 1/4 NE 1/4 SECTION 16,
T29S R16E, W.M. LOCATED 1313 FEET SOUTH AND
2445 FEET EAST FROM THE NORTH 1/4 CORNER OF
SECTION 16.

NEWLY INSTALLED METER IS APPROXIMATELY 5.0 FEET
EAST ALONG DELIVERY PIPE FROM CENTER POINT.

THIS MAP IS FOR THE PURPOSE OF LOCATING A WATER
RIGHT ONLY AND HAS NO INTENT TO PROVIDE LEGAL
DIMENSIONS OR THE LOCATION OF PROPERTY LINES

PREPARED FOR:

PERNOLL RANCH, LLC
P.O. BOX 35
SUMMER LAKE, OR 97640

PREPARED BY:



ALL POINTS ENGINEERING AND SURVEYING, INC.
P.O. BOX 767 (CRR) TERREBONNE, OR 97760
(541) 548-5833
www.APEandS.com