


T. 1 N., R. 3 E. W.M.

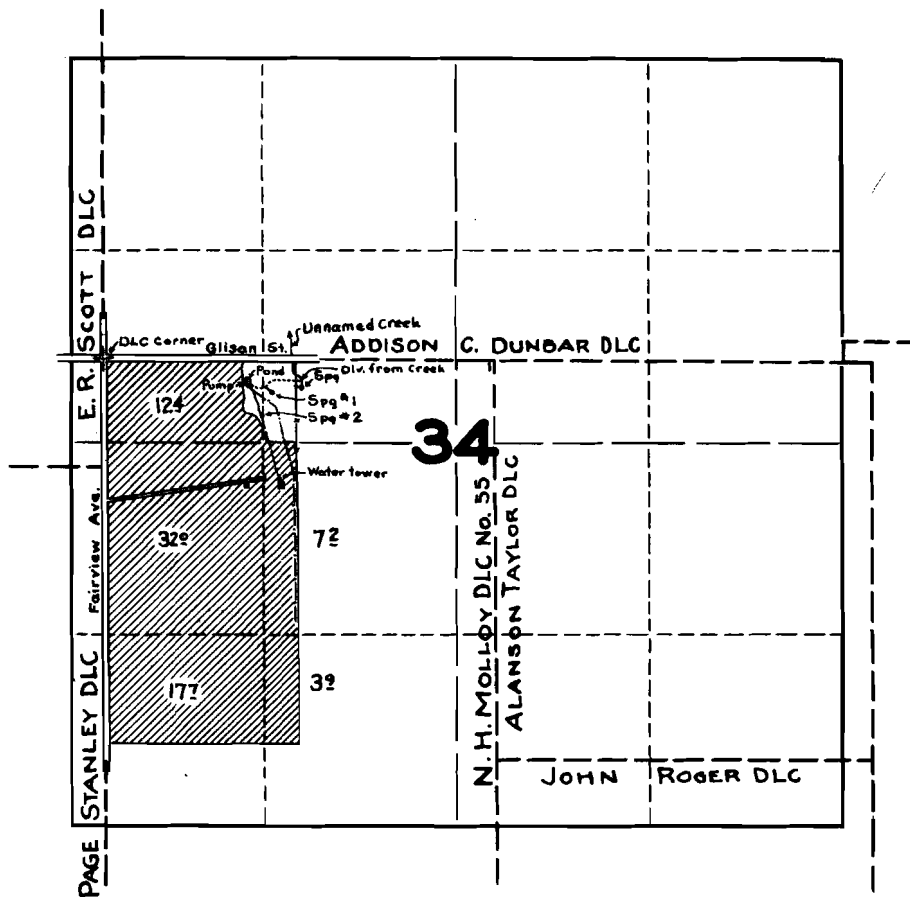

FINAL PROOF SURVEY UNDER

Application No. 19326 Permit No. 14906

IN NAME OF

Wayne E. McGill

Surveyed July 22 1942, by Geot. Maderman