


T. 20S. R. 36E. W.M.

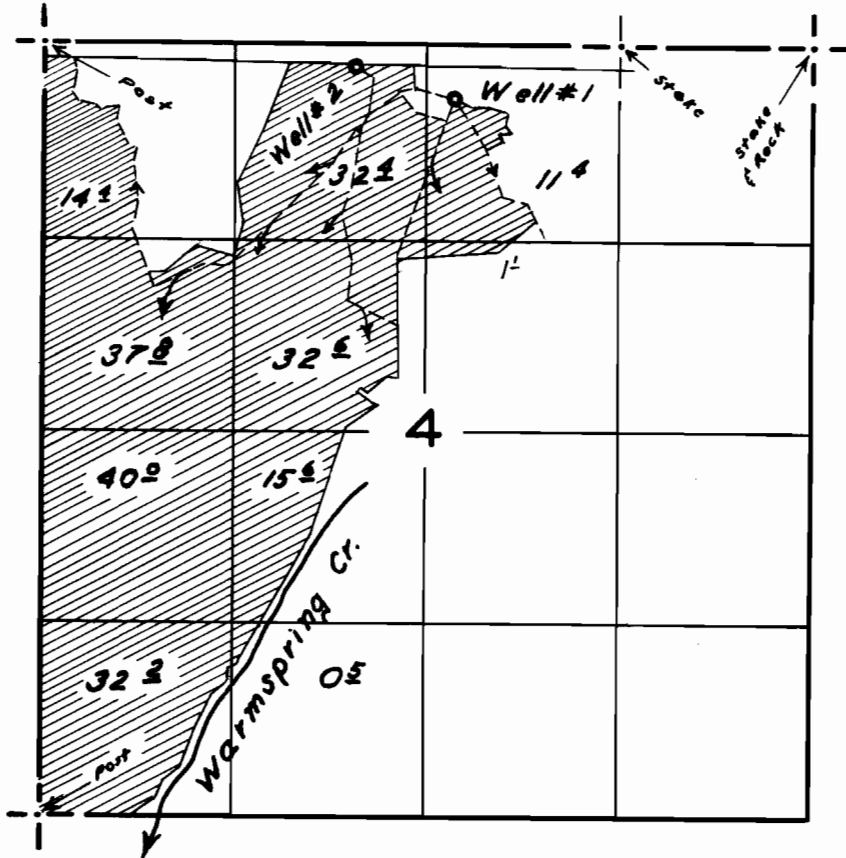

**FINAL PROOF SURVEY**  
UNDER

Application No. U-194 Permit No. U-176  
IN NAME OF

Jos. W. Altnow of Altnow & Sons

Surveyed Aug. 19 1958, by W. N. Parry