

file copy
3/22/02
JLB

OTIS VALLEY IRRIGATION COMPANY

FINAL PROOF SURVEY



UNDER

Application No. R-33144 Permit No. R-4699
33145 31115

Surveyed June & Oct. 1955 by Larry Toll

T. 19 S., R. 36 E., W.M.

T. 20 S., R. 36 E., W.M.

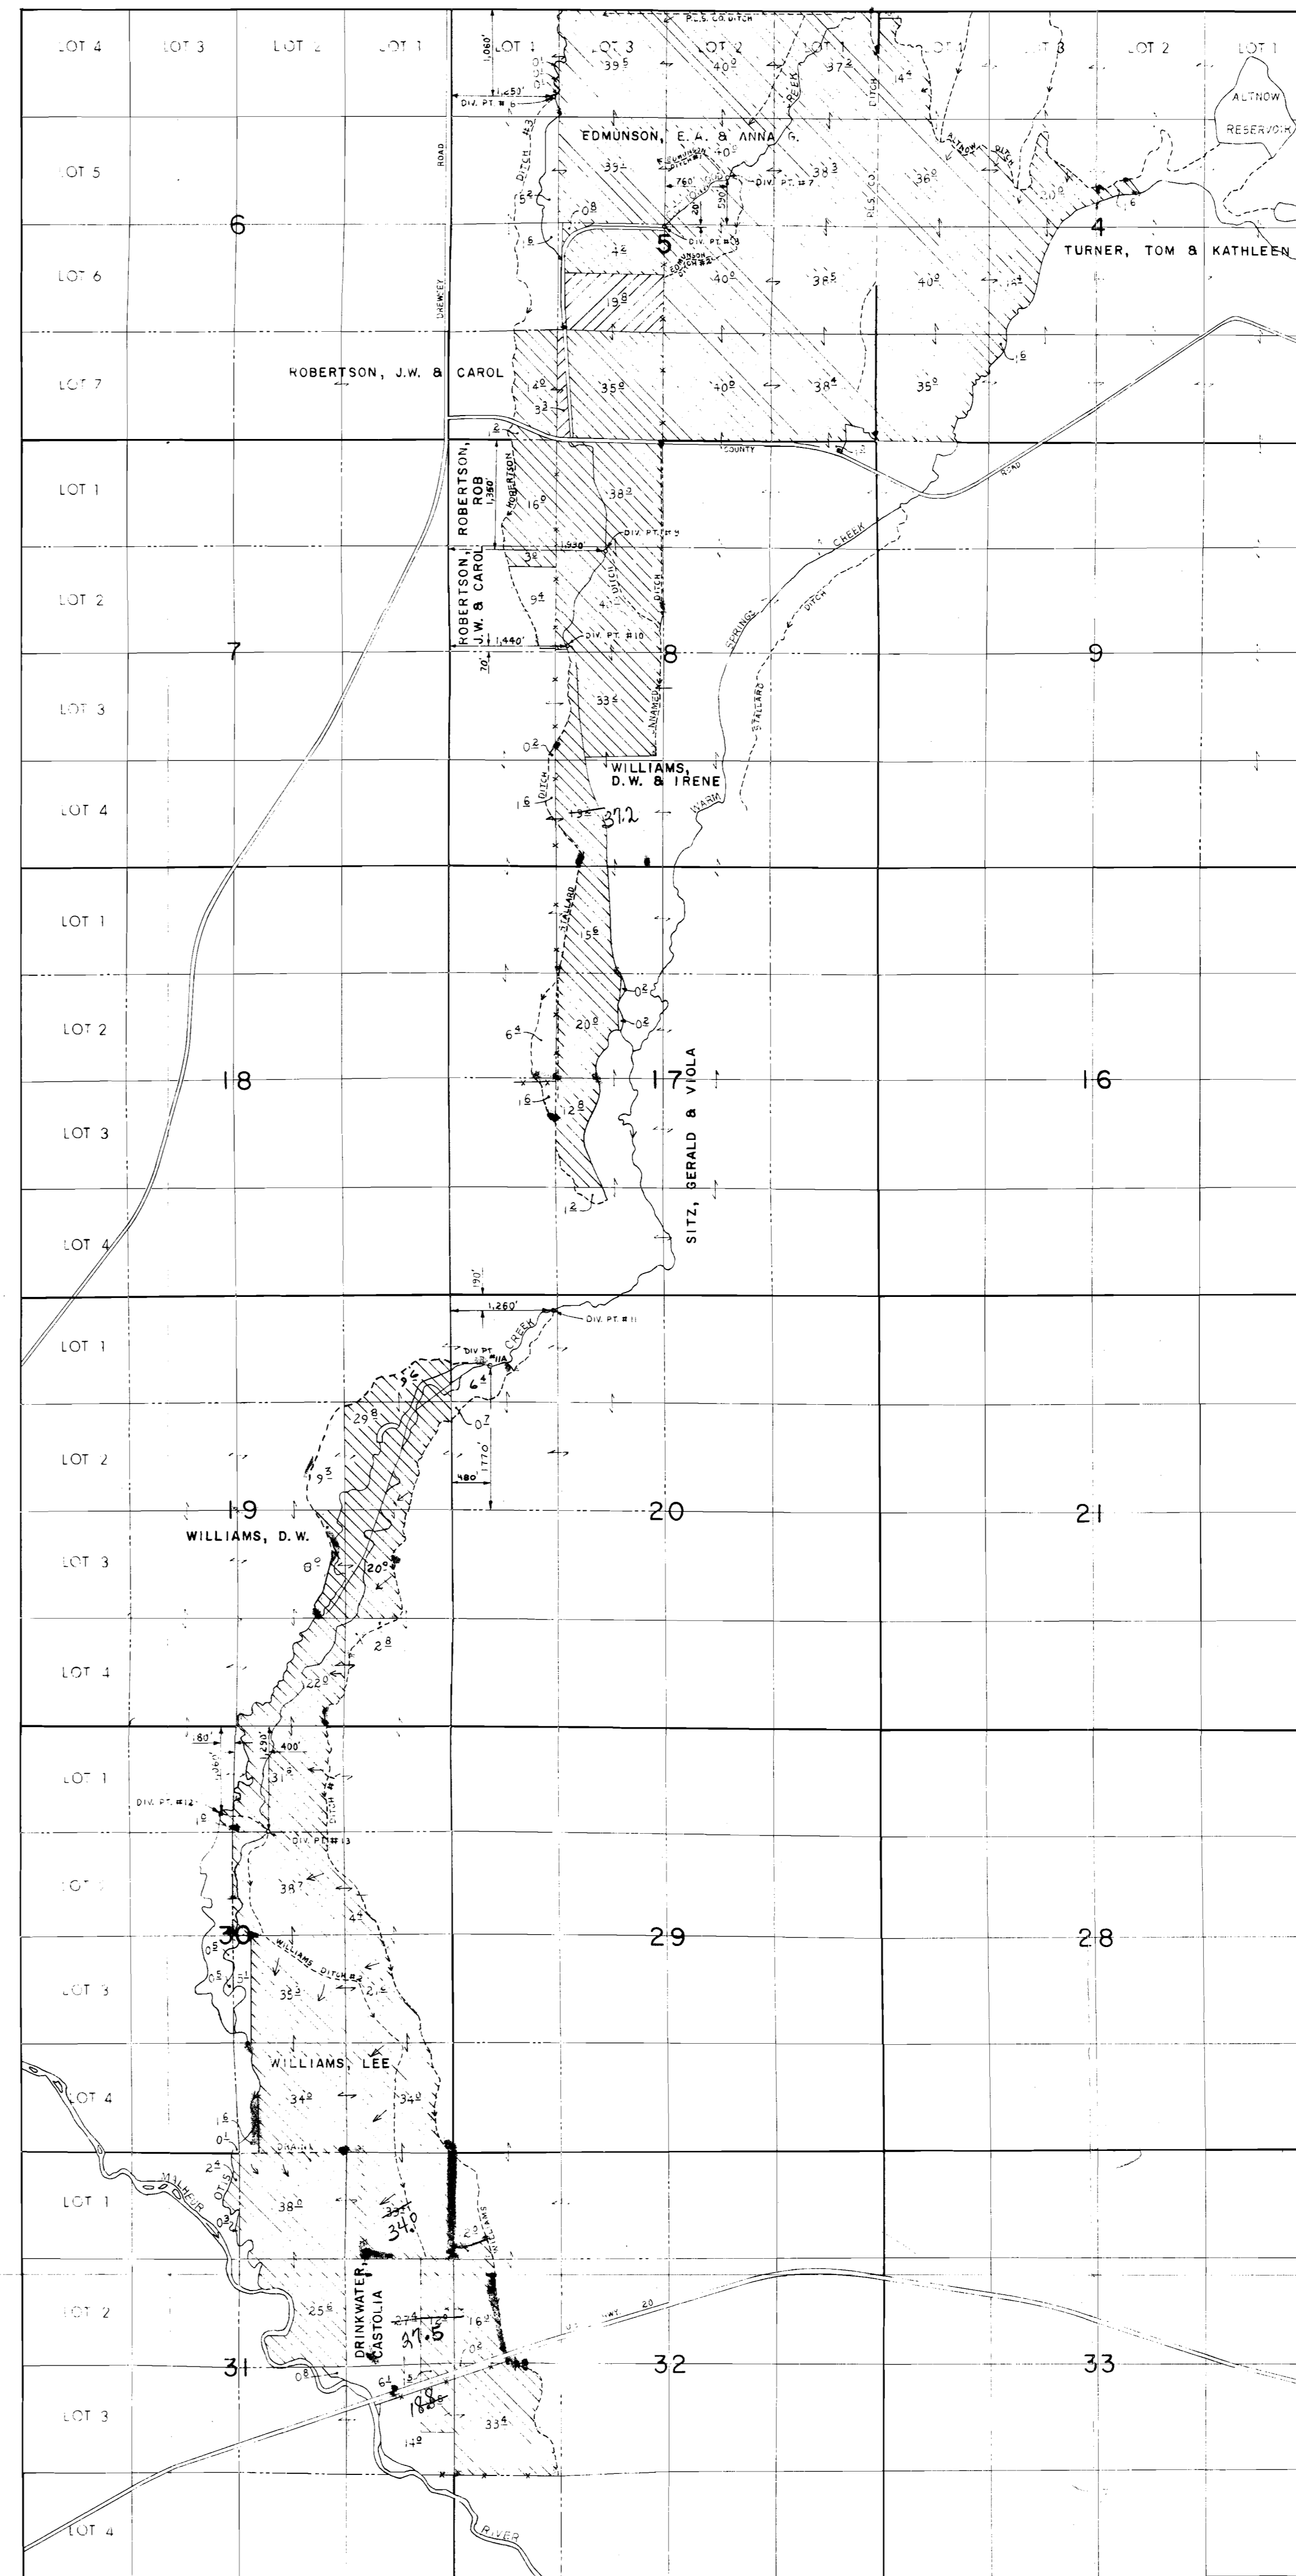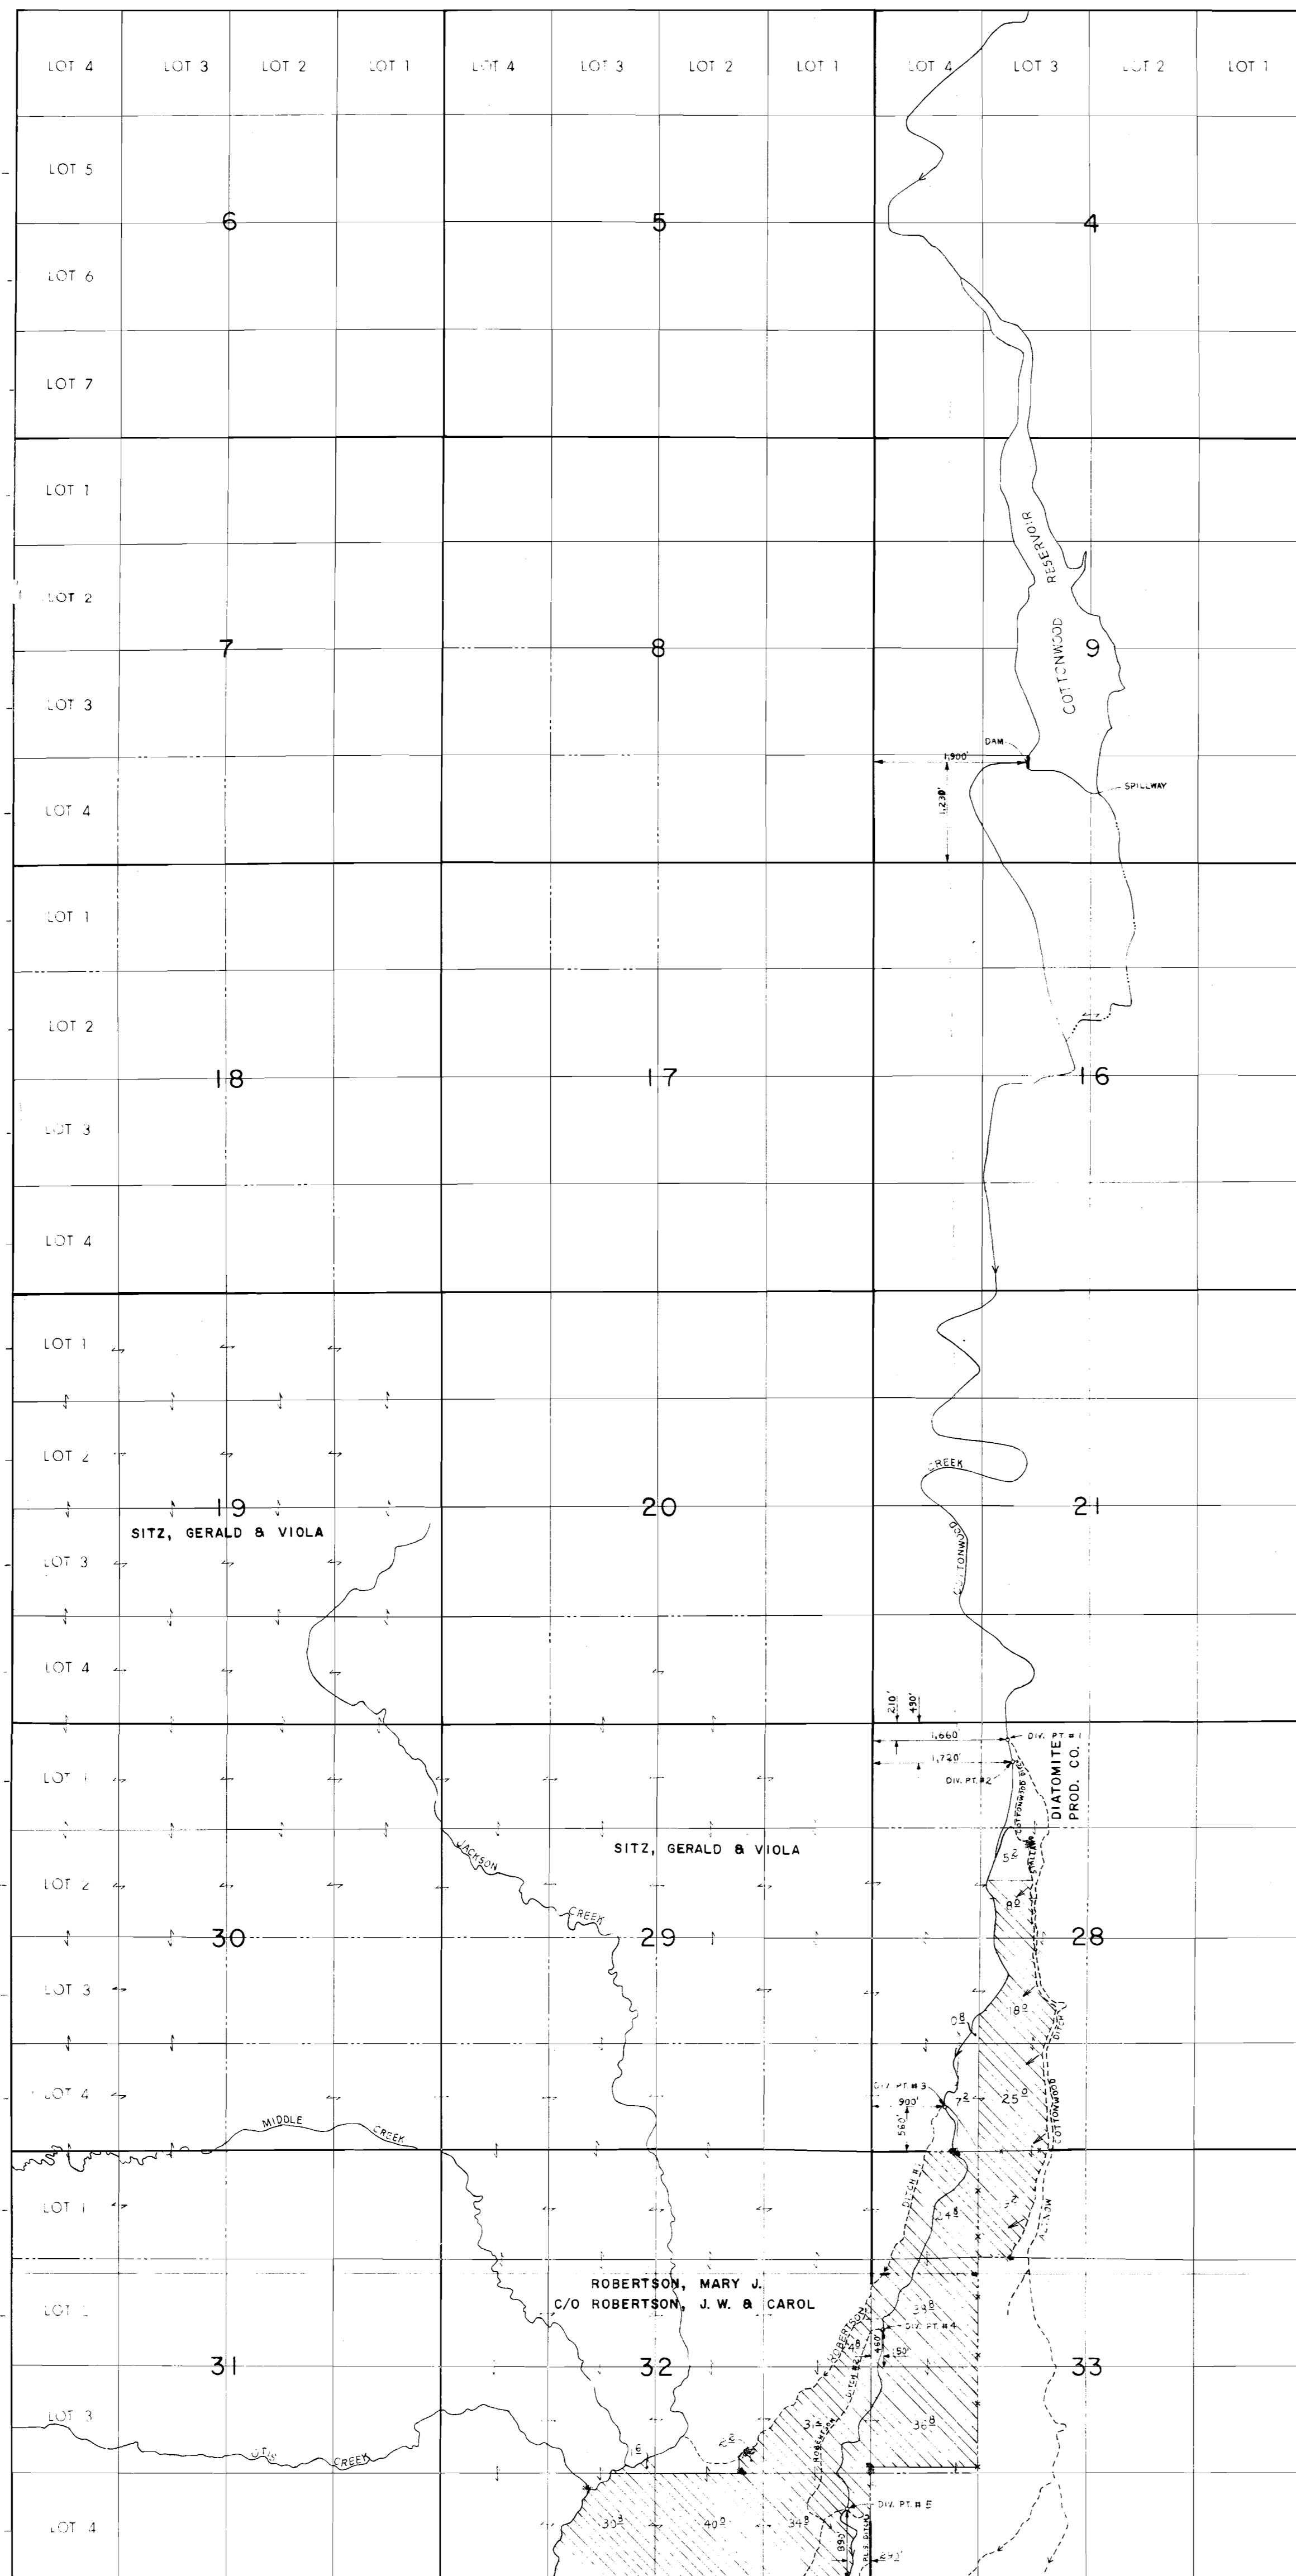

SCALE: 1/4 mile
SUPPLEMENTAL
PRIMARY

file copy
do not remove.
final proof
as corrected
for Certs issued
3/22/02
JLB

RECEIVED
AUG 1 6 1989
WATER RESOURCES DIVISION