


Nettie Doerner

Scale 2"=1 Mile - Mar. 1927

T. 37 S., R. 6 W., W. M.

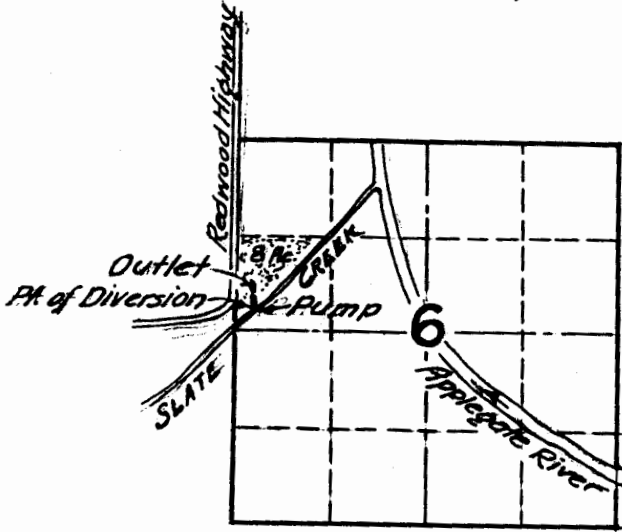

APPLICATION NO.
Permit No

11359

7821