

FEB 18 2014

# Claim of Beneficial Use Map

Permit R-14290, Application R-86528  
Water Right in the Name of Larry Martin

SALEM, OR

Township 37 South, Range 4 West (W.M.)



File Path: P:\Portland\506-Troon\Project\_GIS\Project\_mxd\COBU\_R14290.mxd. Date: December 3, 2013 2:25:52 PM


**LEGEND**

- Point of Diversion (POD)
- Place of Use (POU)
- Donation Land Claim (DC)
- Government Lot (L)
- Tax Lot
- Intermittent Stream
- Waterbody

**POD Location Description**

**POD - Center of Dam**  
Located 325 feet North and 630 feet East from the SW corner of Section 31, Township 37 South, Range 4 West (W.M.)

**Certified Water Rights Examiner Stamp**

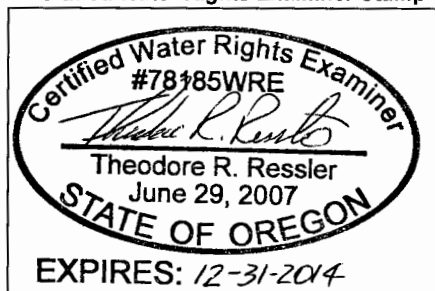

**Disclaimer**

This map was prepared for the purpose of identifying the location of a water right only and it is not intended to provide legal dimensions or location of property ownership lines.

**Map Notes**

Date: January 10, 2014  
Data Sources: BLM, Jackson Co, ESR  
Prepared By: GSI Water Solutions, Inc.

