



WISKIYOU NATI

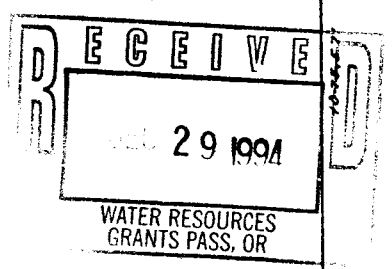

SEE MAP 40 8 19

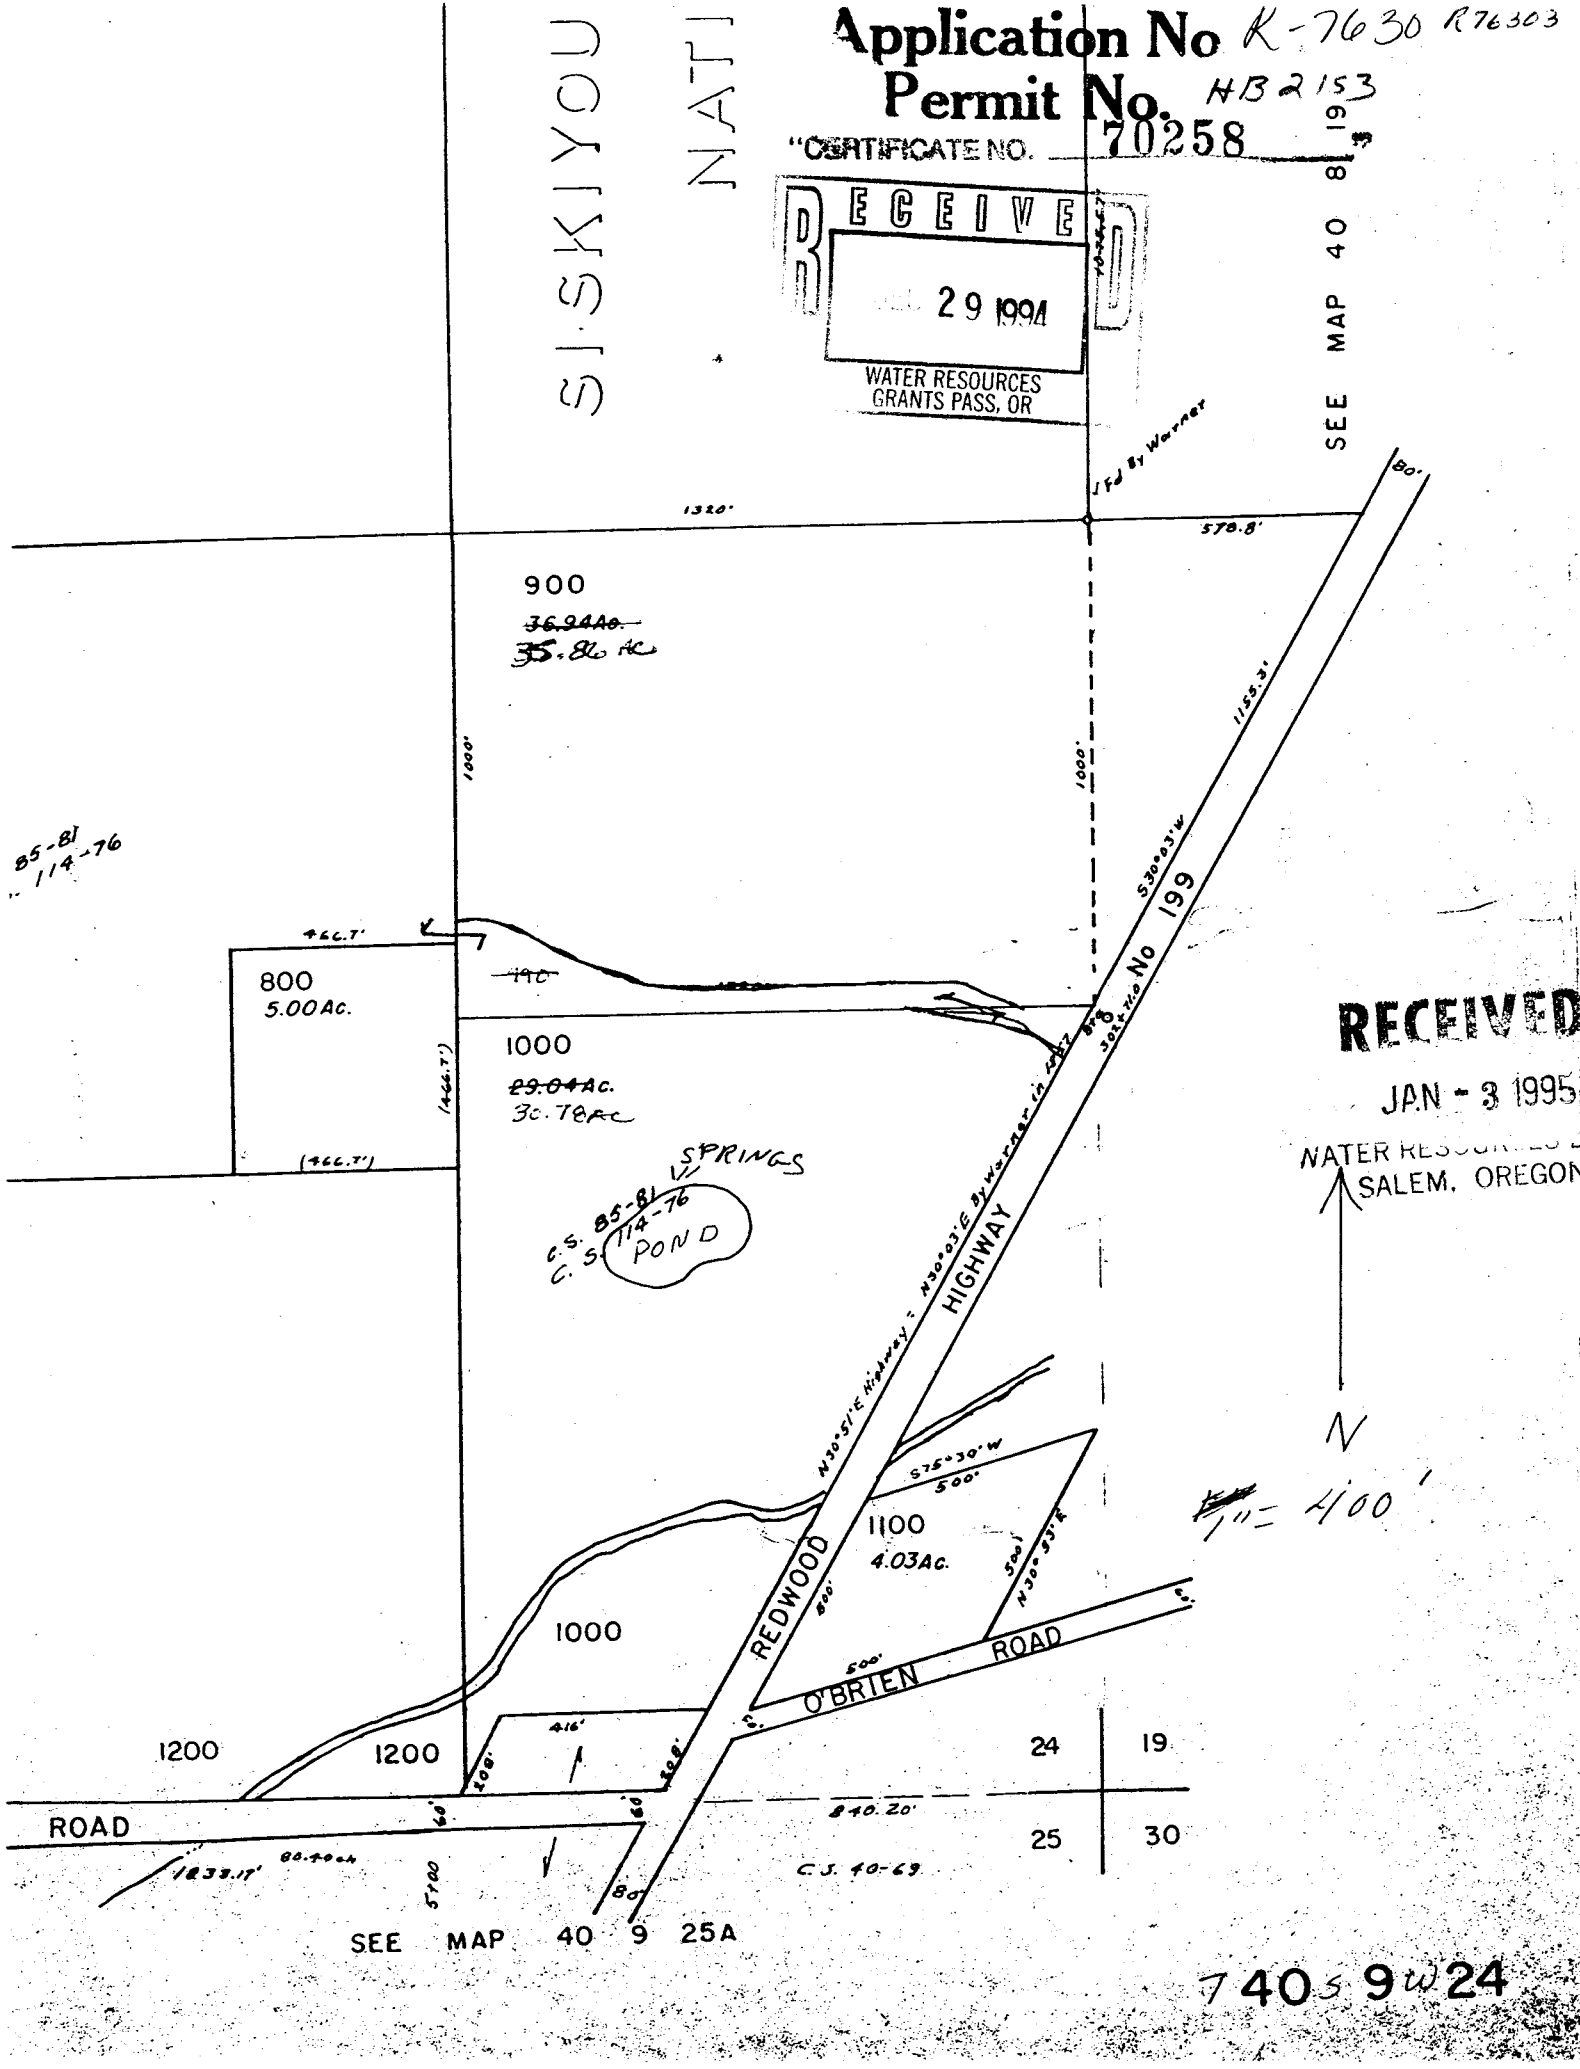

RECEIVED

JAN - 3 1995

WATER RESOURCES DIVISION SALEM, OREGON

N

1" = 400'

SEE MAP 40 9 25A

7 40 S 9 W 24