


T. 28 S. R. 14 & 15 E. W.M.

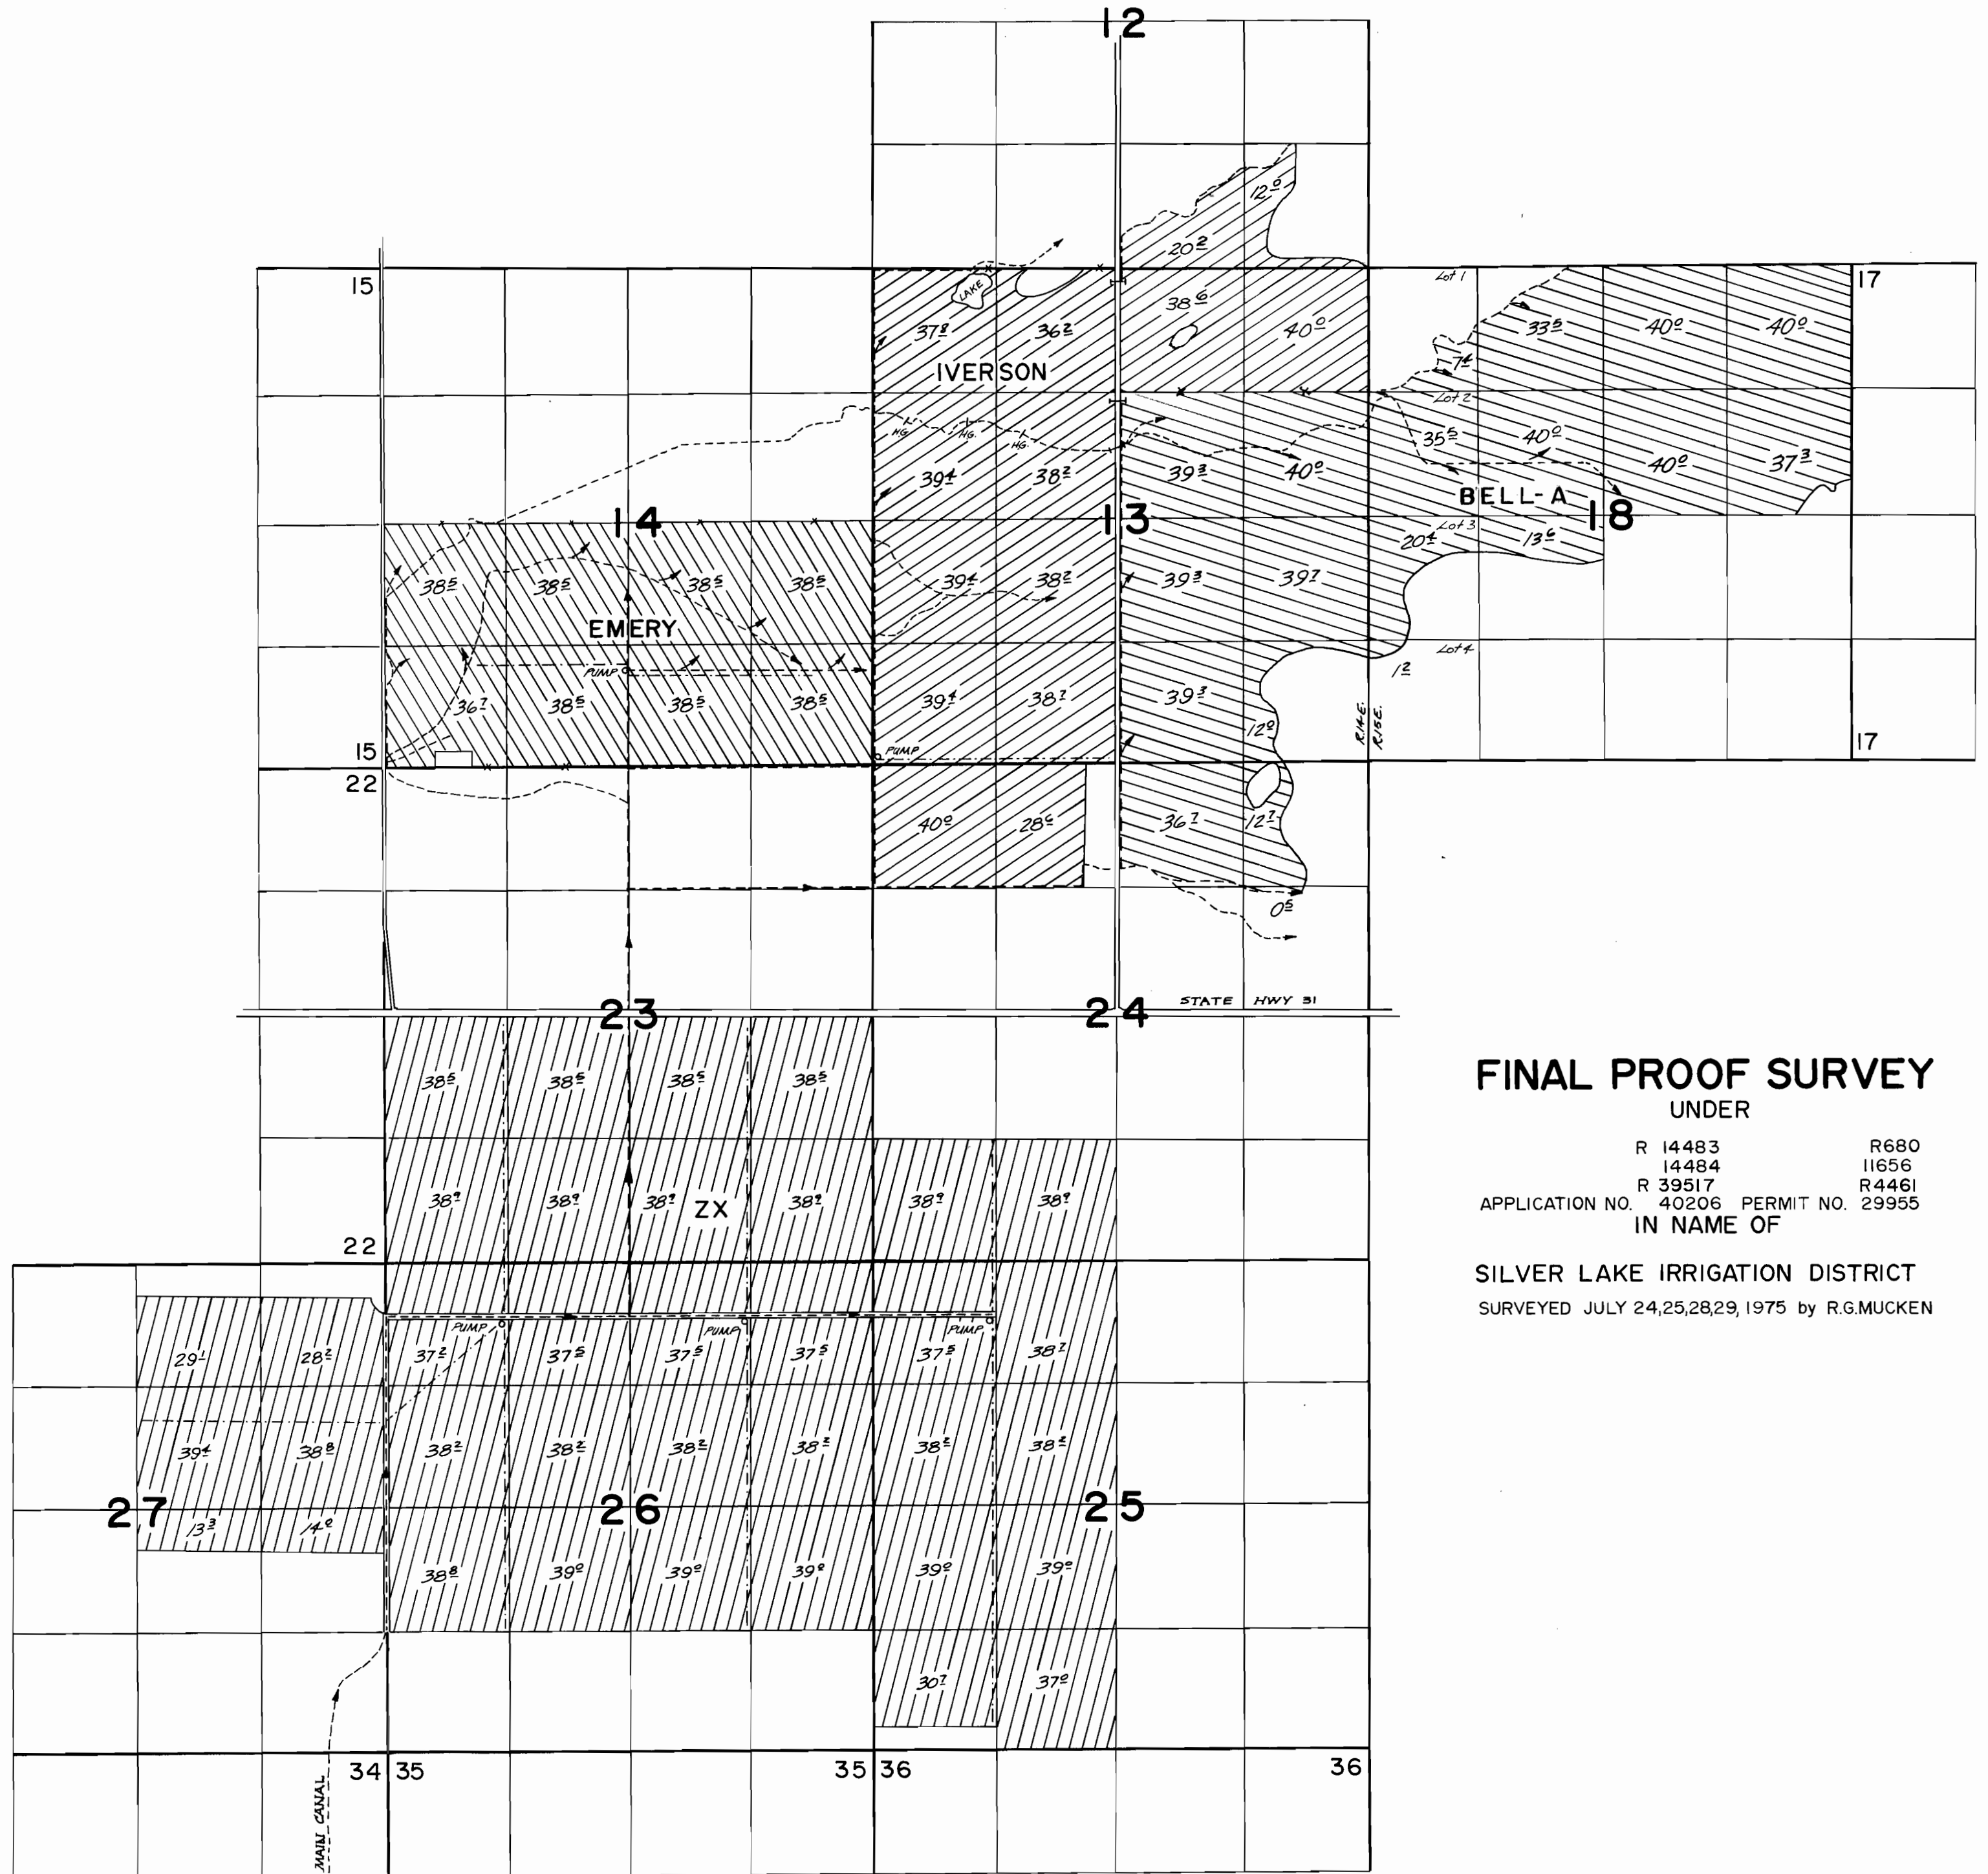

FINAL PROOF SURVEY

UNDER
 R 14483 R680
 14484 11656
 R 39517 R4461
 APPLICATION NO. 40206 PERMIT NO. 29955
 IN NAME OF

SILVER LAKE IRRIGATION DISTRICT
 SURVEYED JULY 24,25,28,29,1975 by R.G.MUCKEN