


Claim of Beneficial Use Map  
Permit S-36172, Application S-48026  
Water Right in the Name of City of Cave Junction  
Township 39 South, Range 8 West (W.M.)

COBU MAP #815

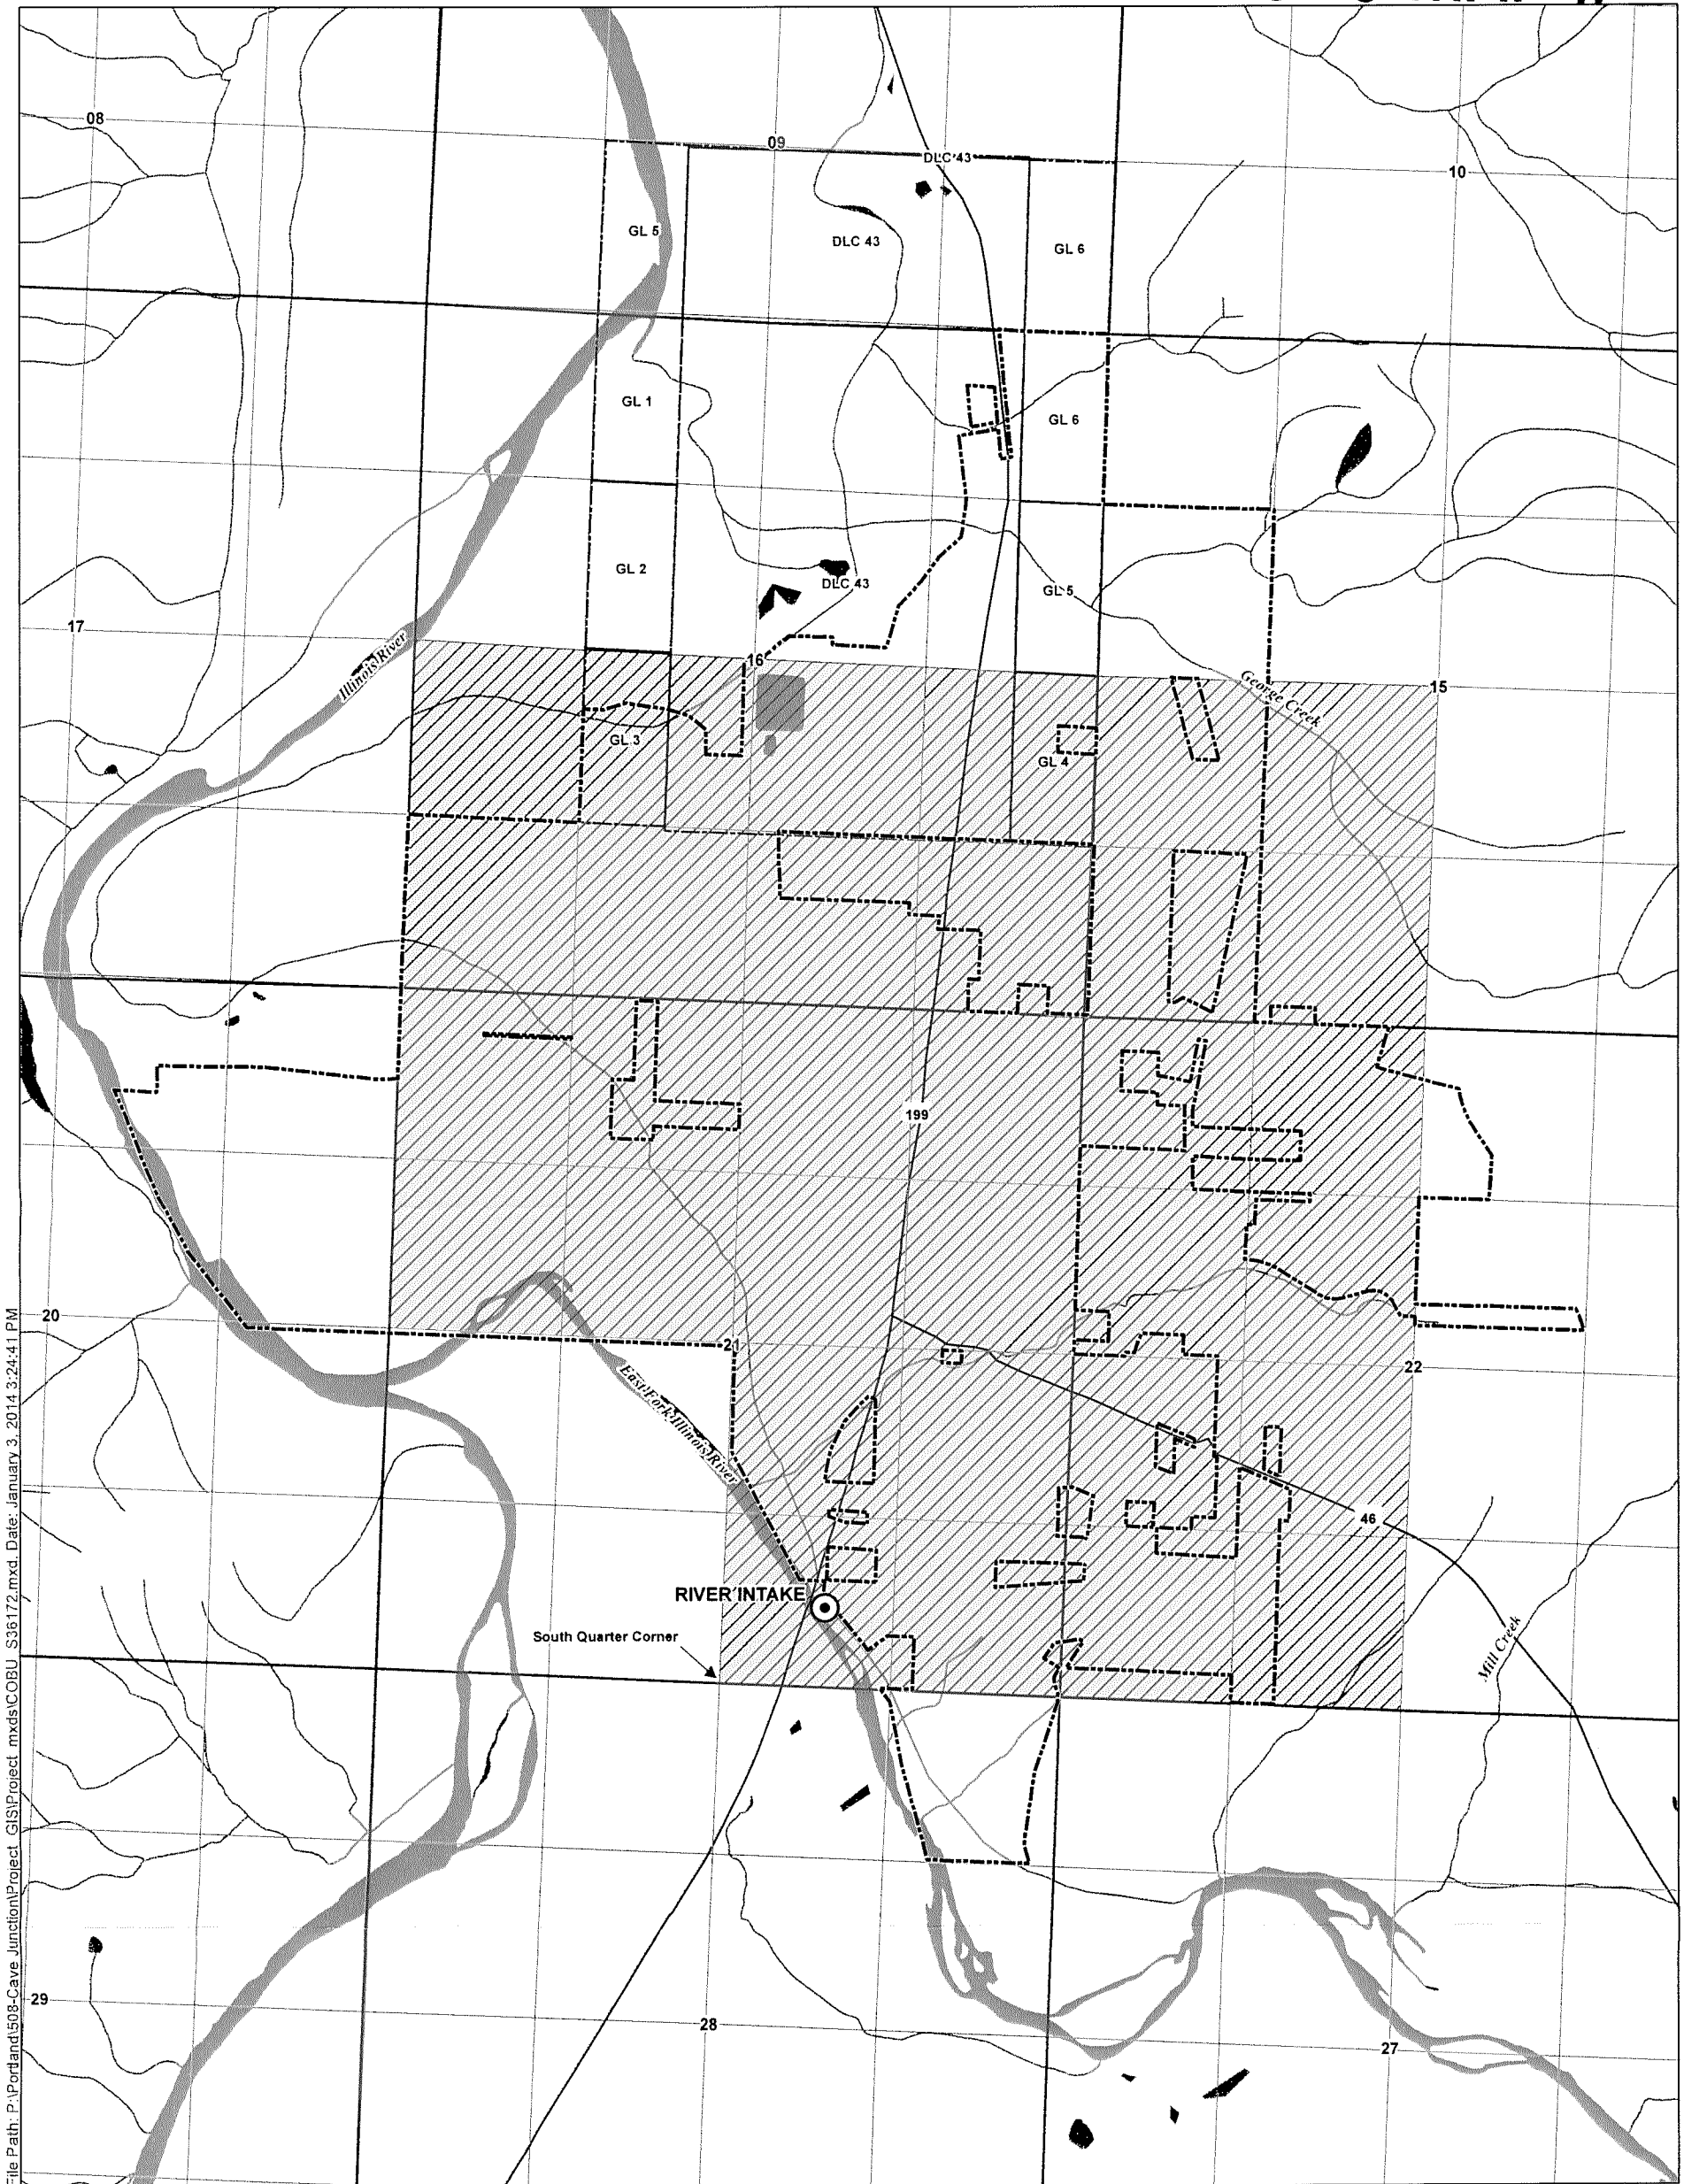

File Path: P:\Portland\508-Cave Junction\Project GIS\Project mxd\COBU\_S36172.mxd Date: January 3, 2014 3:24:41 PM


LEGEND

- Point of Diversion (POD)
- Place of Use (POU)
- Donation Land Claim (DLC)
- Government Lot (GL)
- Cave Junction City Limit
- Road
- Watercourse
- Waterbody

POD Location Description

**River Intake**  
Located 670 feet North and 770 feet East from the South quarter corner of Section 21, Township 39 South, Range 8 West (W.M.)

Certified Water Rights Examiner Stamp

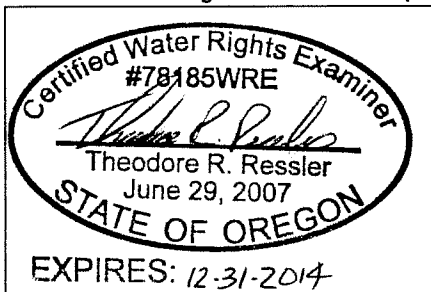

**Disclaimer**  
This map was prepared for the purpose of identifying the location of a water right only and it is not intended to provide legal dimensions or location of property ownership lines.

**Map Notes**  
Date: January 3, 2013  
Data Sources: ESRI, BLM, USGS  
Prepared By: GSI Water Solutions, Inc.

RECEIVED BY OWRD

MAR 07 2014

