


TOWNSHIP 17 SOUTH, RANGE 22 EAST, W.M.

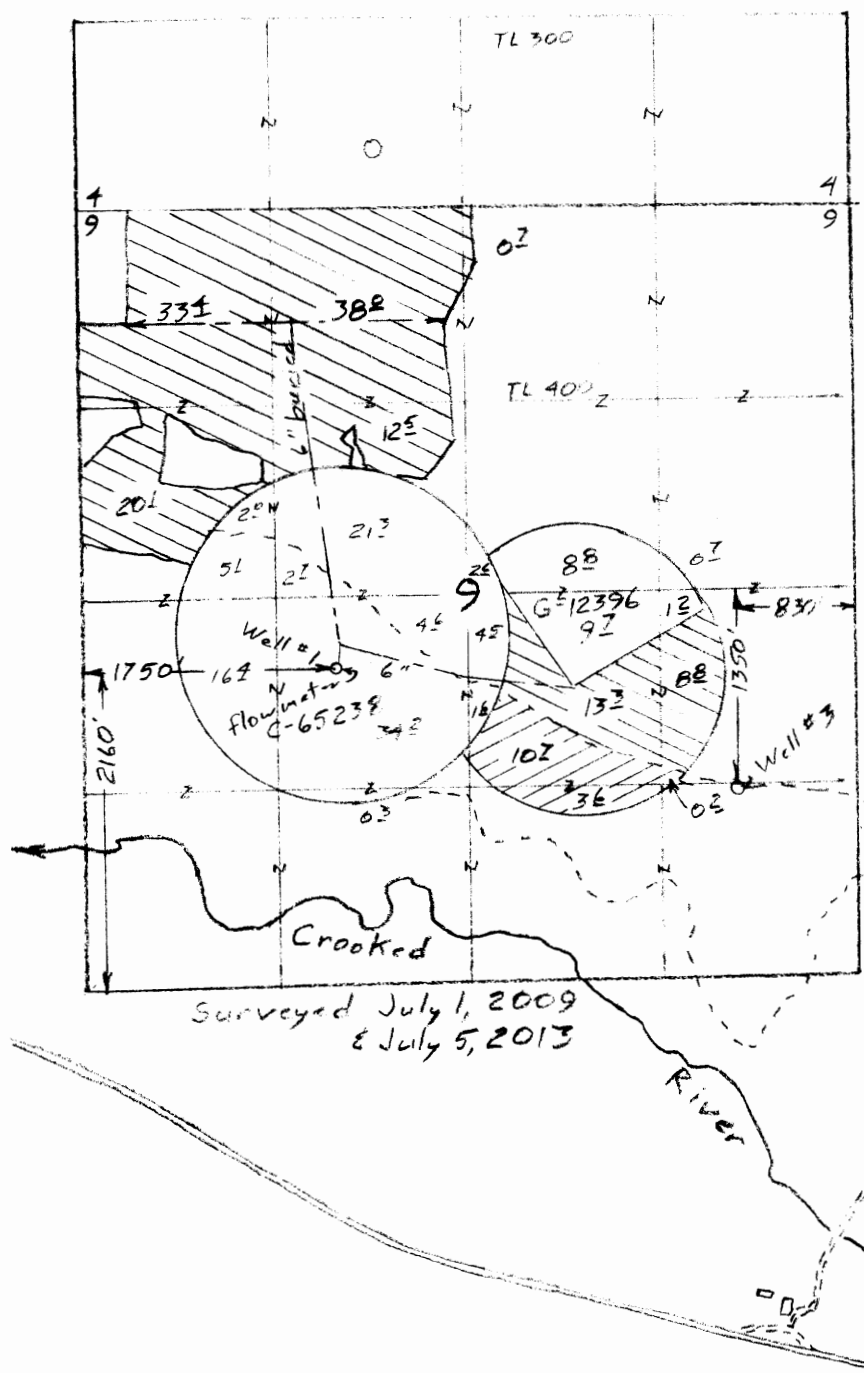

Scale 1" = 1320'
(4" = 1 mile)

RECEIVED
ESTES SURVEYS
L.L.C.

App G-14500
Per G-13270

- ⊗ Primary 126[±]
- ⊗ Supp. 14[±] acres

Surveyed July 1, 2009
& July 5, 2013

Claim of Beneficial Use Map
for
Oregon Ranching Co, Twin Buttes Ranch



This map is for the purpose of locating a water right only and has no intent to provide legal dimensions or the location of property lines.

ESTES SURVEYS, LLC
 PG-Box-17548
 Salem, OR-97308-7518
 (503) 565-7589
 60362 Arnold Rd
 Bend, OR 97702
 (541) 382-7391