


TOWNSHIP 17 SOUTH, RANGE 22 EAST, W.M.

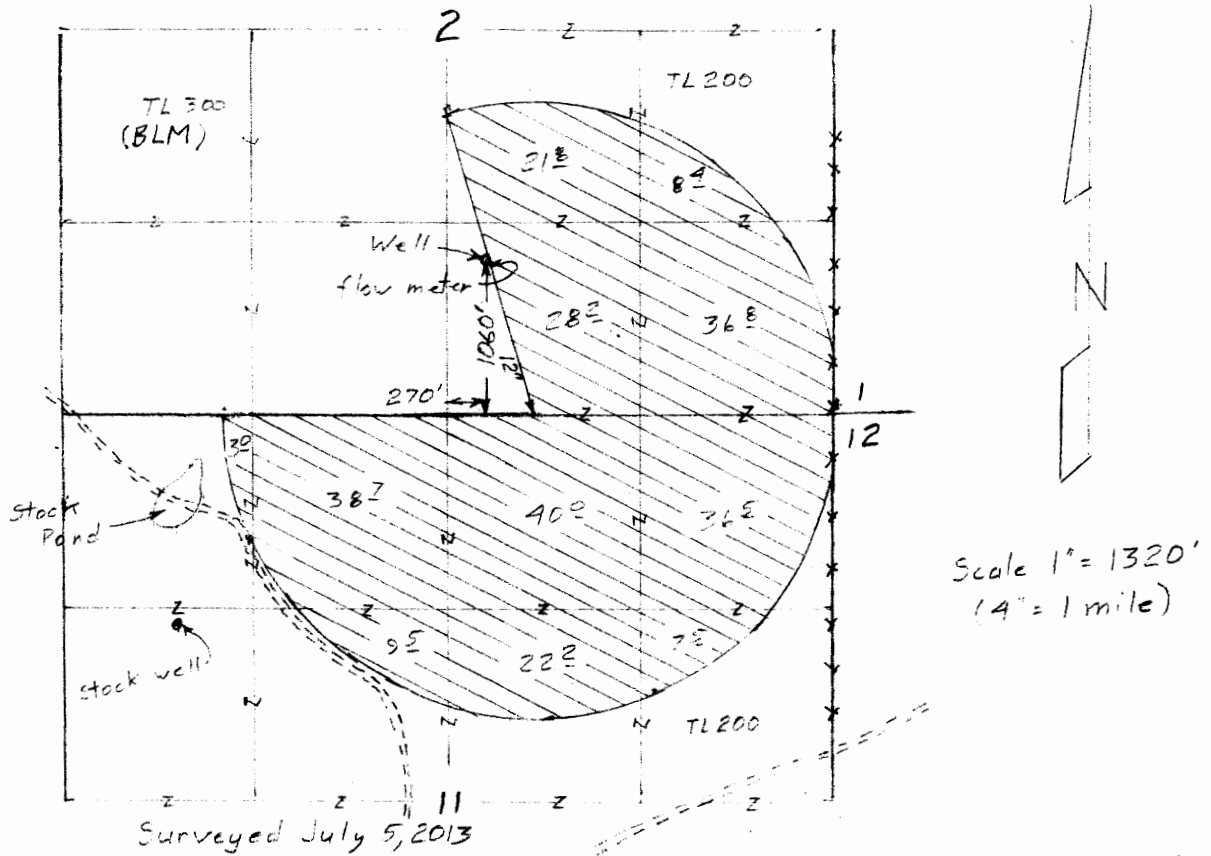


⊗ Irrigation 252<sup>6</sup> acres

APP G-16966  
Per G-16458

Claim of Beneficial Use Map  
for  
OREGON RANCHING Co.  
(Twin Buttes Ranch)

RECEIVED

IAN 27 2014

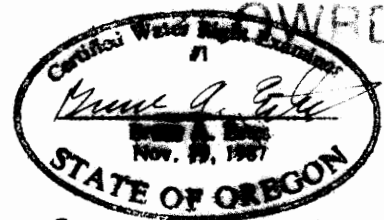

Renewal Dec 31, 2013

This map is for the purpose of locating a water right only and has no intent to provide legal dimensions or the location of property lines.

**ESTES SURVEYS, LLC**

PG-04-17519  
Batem, OR 97009-7519  
(503) 688-7800

80352 Arnold Rd  
Bend, OR 97702  
(541) 382-7391