


T. 9S. R. 5W. W.M.

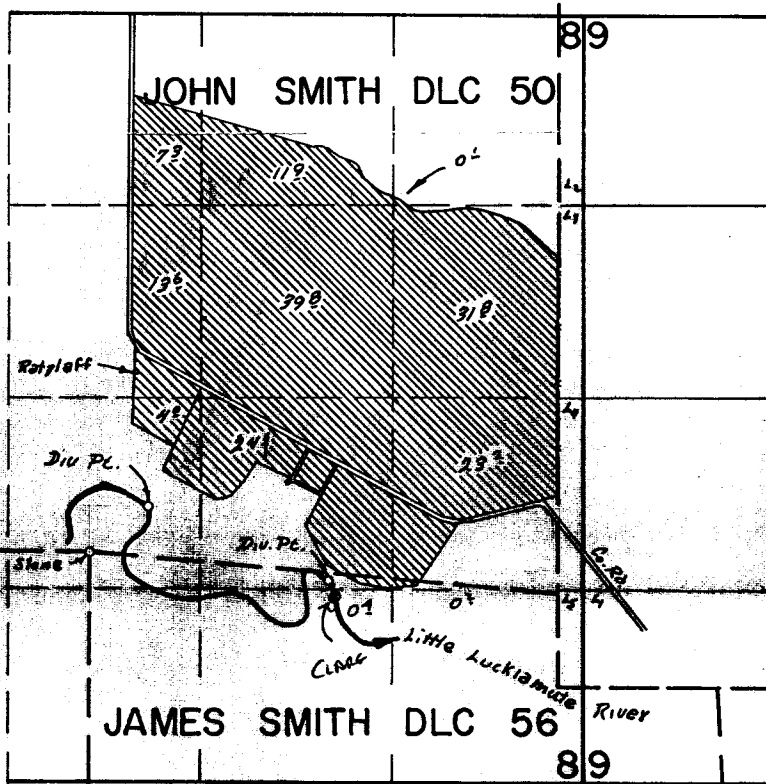

Div. Pl. Loc: 200' W & 400' N ; 200' S & 1630' E Back from NW Cor James Smith DLC 56

**FINAL PROOF SURVEY**  
UNDER

Application No. 43358 Permit No. 32204  
IN NAME OF

VERDA CROOK

Surveyed March 29 1973, by R. D. Mucken