## MEYER VINEYARD


CLAIM OF BENEFICIAL USE MAP

LOCATED IN THE C.HANDLEY DLC #56, BEING PORTIONS OF THE NE 1/4 OF THE NW 1/4 AND PORTIONS OF THE SE 1/4 OF THE NW 1/4 OF SECTION 27. TOWNSHIP 3 SOUTH, RANGE 3 WEST, WILLAMETTE MERIDIAN. YAMHILL COUNTY, OREGON



APPLICATION #G-15456

PERMIT#G-15234

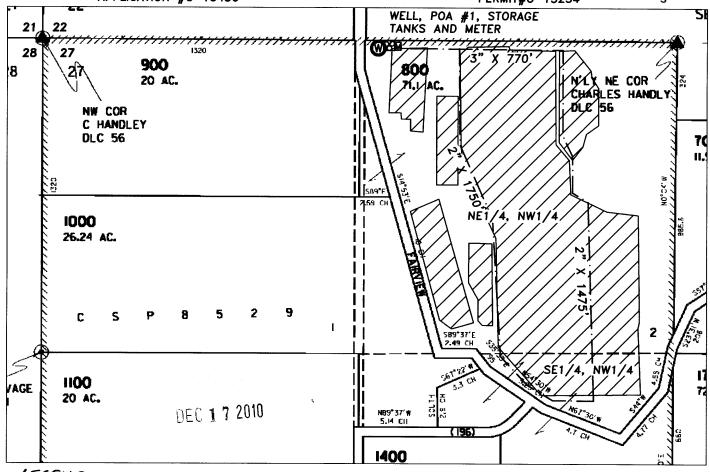

LEGEND

DLC CORNER


FLOW METER

WATER WELL (P.O.A.) IS LOCATED 20' SOUTH AND 1400' EAST OF THE NW COR. OF THE C.HANDLEY DLC #56.

IRRIGATION AREAS - 21.5 ACRES BEING 19.6 ACRES IN NE1/4, NW1/4 1.9 ACRES IN THE SE1/4, NW1/4

EXISTING MAIN IRRIGATION PIPE LINES

THIS MAP WAS PREPARED FOR THE PURPOSE OF IDENTIFYING THE LOCATION OF A WATER RIGHT ONLY AND IS NOT INTENDED TO PROVIDE LEGAL DIMENSIONS OR LOCATION OF PROPERTY OWNERSHIP LINES.

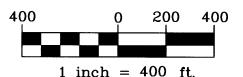

MAP BASE: YAMHILL COUNTY TAX MAP SECTION 27, T3S, R3W

PREPARED FOR: LEMELSON VINEYARDS 12020 NE STAG HOLLOW ROAD

CARLTON, OR. 97111



EXPIRES 6/30/2011



Project: 310-2-045B PH.203 Drawing: G15456B.dwg

By: JMH

Checked by: TMH Date: 8-3-2010