


T.25 S., R.30 E., W.M.

RECEIVED

JAN 15 1992

WATER RESOURCES DEPT
SALEM, OREGON

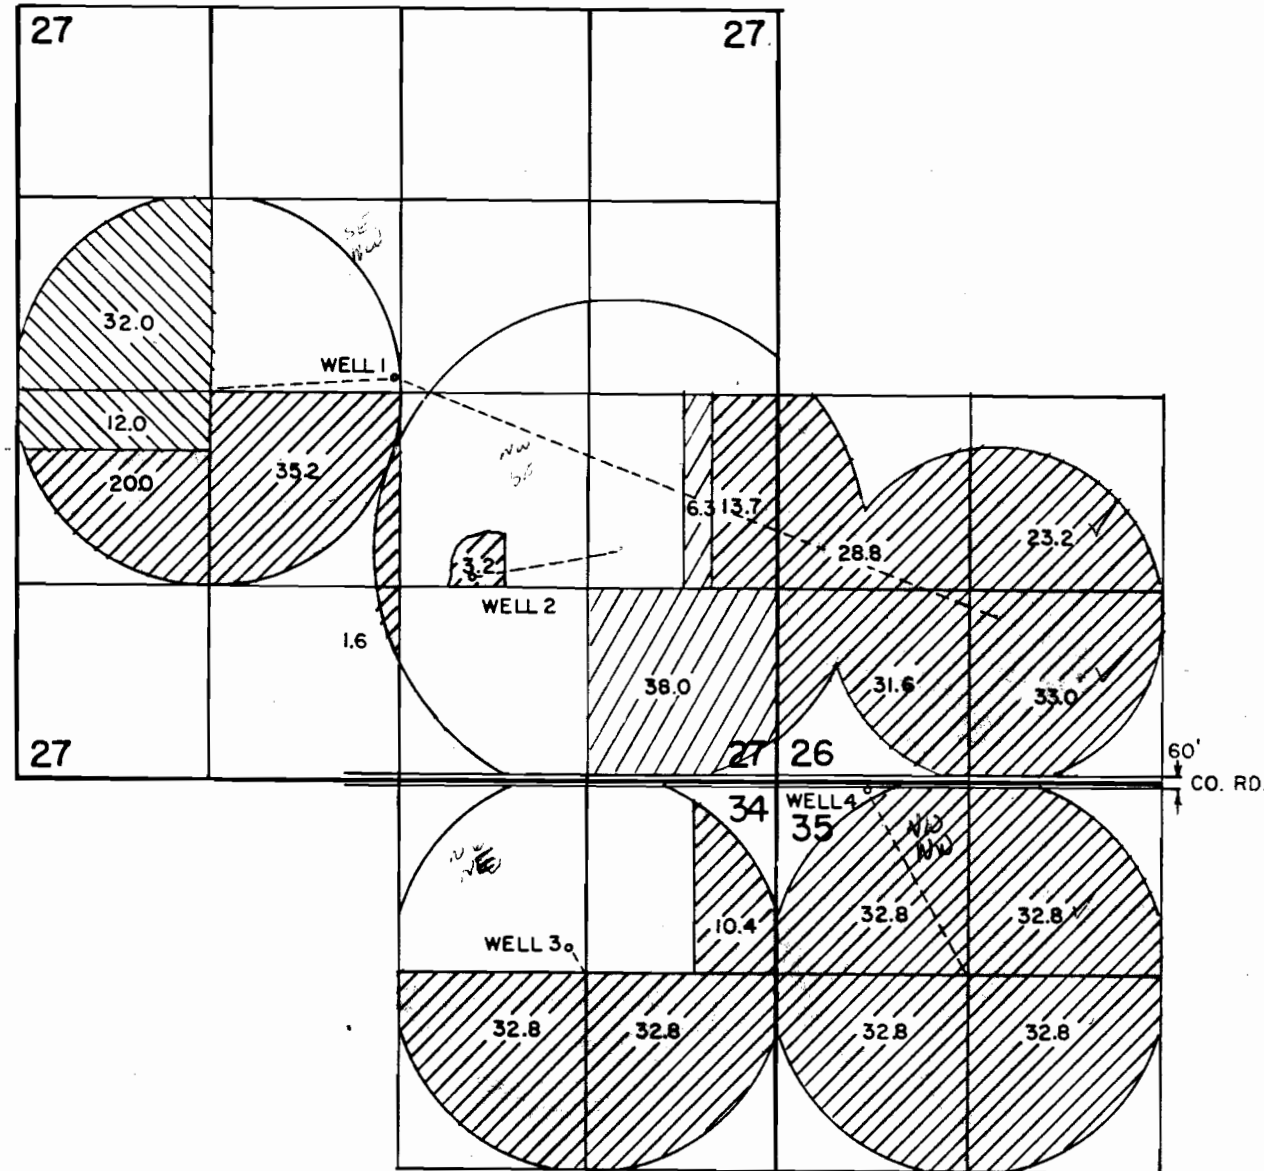

WELL LOCATIONS

WELL 1	70' N & 10' W	FROM C1/4 CORNER SEC 27	
" 2	1230' S " 510' E	" " " "	" "
" 3	1155' S " 1420' W	" NE " "	34
" 4	40' S " 670' E	" NW " "	35

FINAL PROOF SURVEY

UNDER

- /// TRANSFER NO. 6473
- /// PERMIT NO. G-11242, APPLICATION NO. G-12396 397 E
- /// PERMIT NO. G-11320, APPLICATION NO. G-12539

IN THE NAME OF

DOUG & DELORES STILLS

THE PURPOSE OF THIS MAP IS TO IDENTIFY THE LOCATION OF THE WATER RIGHT. IT IS NOT INTENDED TO PROVIDE INFORMATION RELATIVE TO THE LOCATION OF PROPERTY OWNERSHIP.

	STILLS		CULVER, OR
	<u>FINAL PROOF SURVEY</u>		
	Scale: 4" = 1 mile	Date: Jan. 1992	Job: 1279
	Dsn:		Sht. No. 1
	Drm: Chris		of 1
Ckd:	M. A. PALMER & SONS, INC. ENGINEERING & SURVEYING 254 N. Alder - Box 61 Burns, Oregon 97720		