


RECEIVED

APR 25 2014


WATER RESOURCES DEPT
SALEM, OREGON

T.38 & 39 S., R.19 E., W.M.

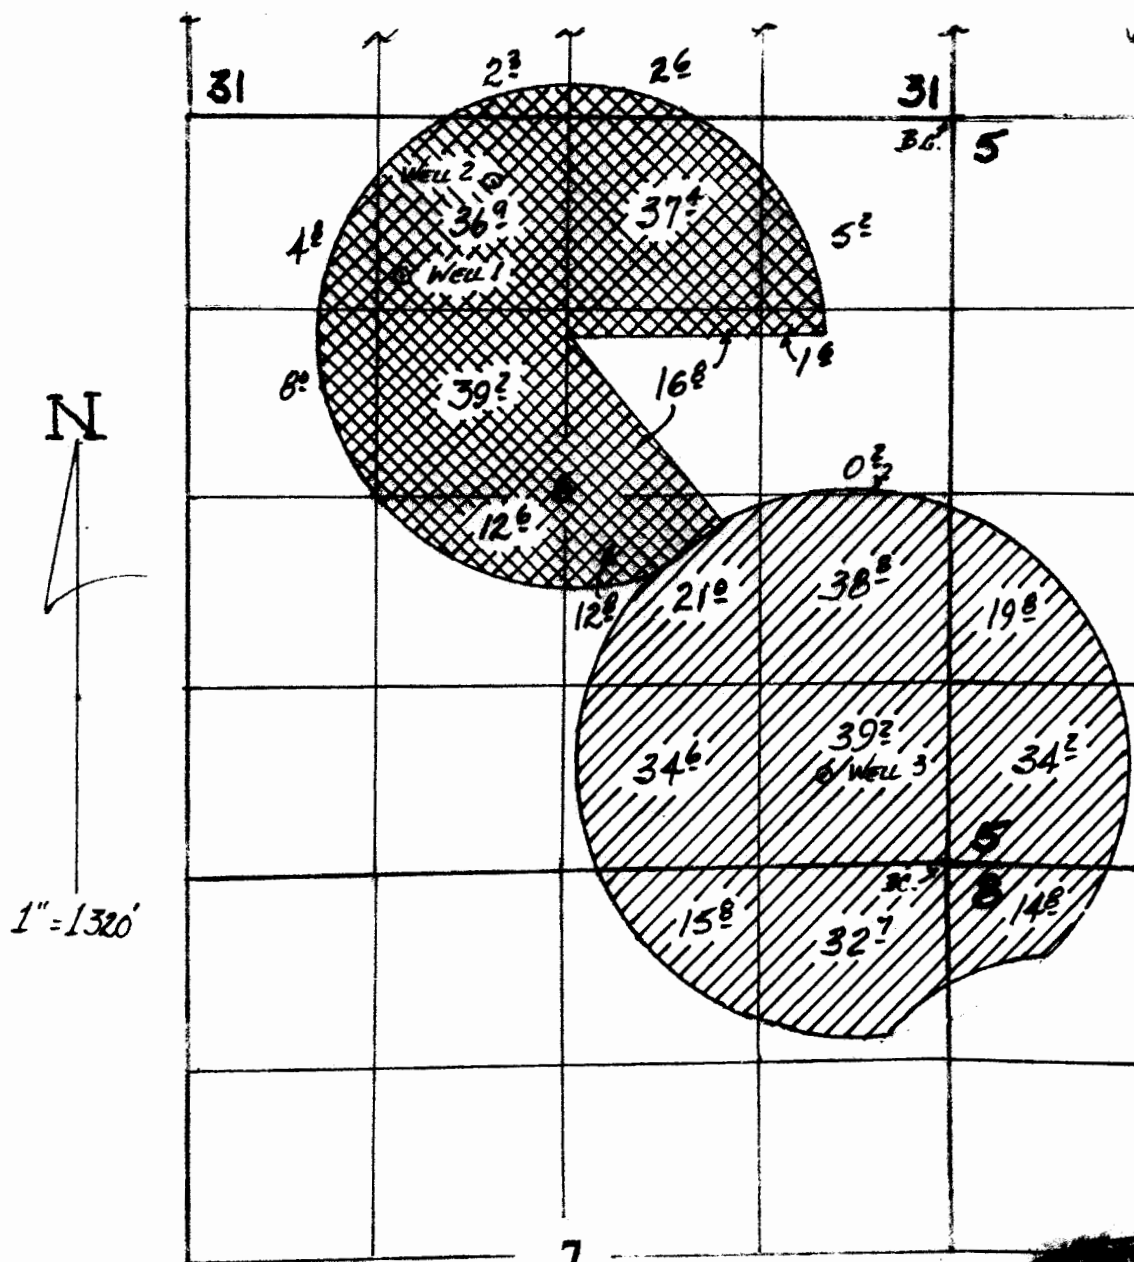

RECEIVED
APR 25 2014
OWRD

CLAIM of BENEFICIAL USE MAP
For
Shine Brothers Ranches, LLC

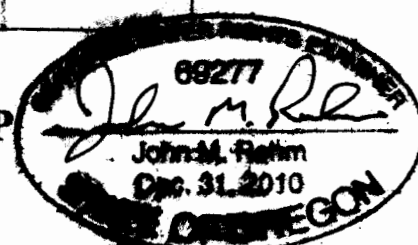

Under Application G-10476, Permit G-9646

Well Locations:

- Well 1- 1120' S. & 3780' W. from the NE Cor. Section 6;
- Well 2- 440' S. & 3150' W. " " " " "
- Well 3- 620' N. & 860' W. from the SE Cor. Section 6

This map is for the purpose of identifying the location of water rights only, and is not intended to provide legal dimensions or locations of property lines.