


FINAL PROOF SURVEY


Application No. T-7849

Permit No. G-10456

Applicant: Eagle-Picher Minerals, Inc.
PO Box 640
Vale, OR 97918

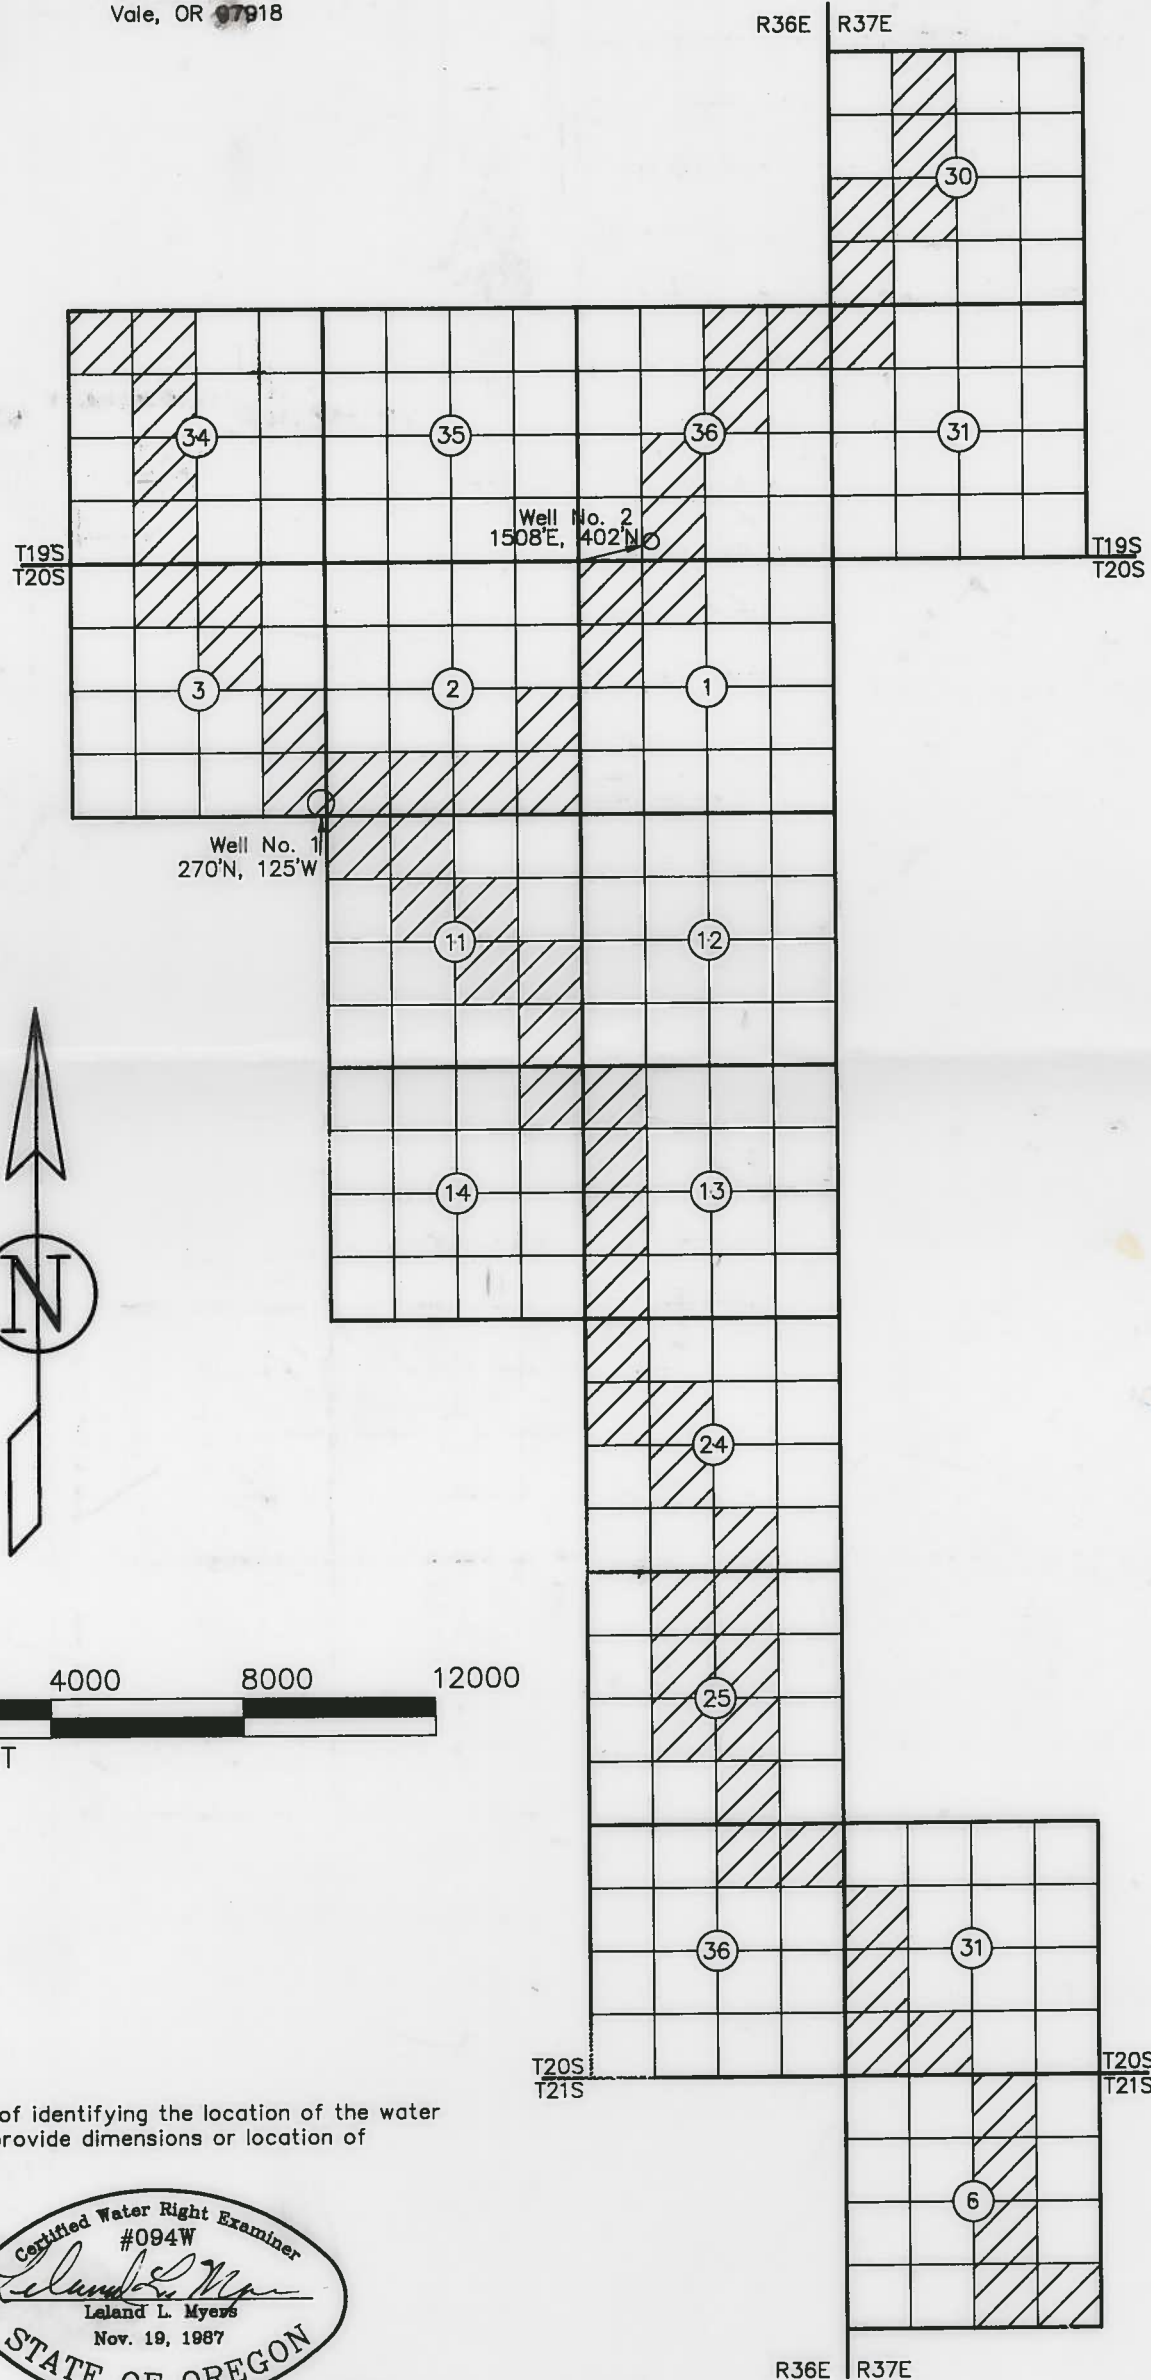

This map is for the purpose of identifying the location of the water right only and has no intent to provide dimensions or location of property ownership lines.

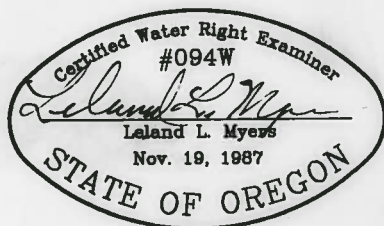

RECEIVED

APR - 6 2000

WATER RESOURCES DEPT.
SALEM, OREGON