


TOWNSHIP 25 SOUTH, RANGE 18 EAST, W.M.

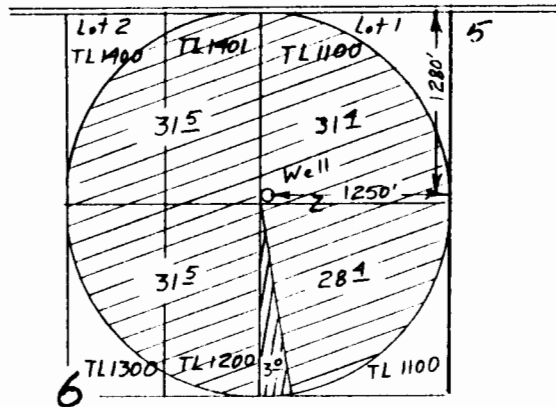

Scale 1"=1320'



⊗ C-53232


⊗ G-7841

Surveyed Sep 4, 2000

Claim of Beneficial Use Map
for

DAVID ROTH

T- 7562

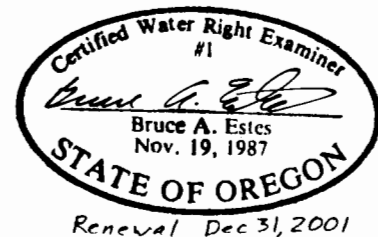

This map is for the purpose of
locating a water right only
and has no intent to provide
legal dimensions or the location
of property lines.

ESTES SURVEYS

PO Box 17519 60382 Arnold Rd
Salem, OR 97305-7519 Bend, OR 97702
(503) 585-7593 (541) 382-7391