



TOWNSHIP 25 SOUTH, RANGE 18 EAST, W.M.

 

Scale 1"=1320'

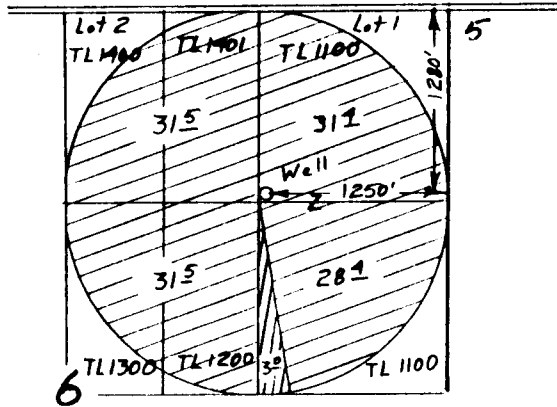


⊗ C-53232

⊙ G-7841

Surveyed Sep 4, 2000

Claim of Beneficial Use Map
for
DAVID ROTH

T- 7562

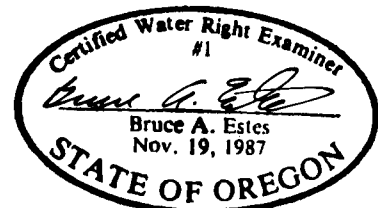

Renewal Dec 31, 2001

This map is for the purpose of locating a water right only and has no intent to provide legal dimensions or the location of property lines.

ESTES SURVEYS

PO Box 17519 60382 Arnold Rd
Salem, OR 97305-7519 Bend, OR 97702
(503) 585-7593 (541) 382-7391