


FINAL PROOF SURVEY MAP
 MT. JEFFERSON FARMS, INC.
 T-8525
 T 9 & 10 S R 2 W, W.M.


RECEIVED
 MAY 15 2005
 WATER RESOURCES DEPT
 SALEM, OREGON

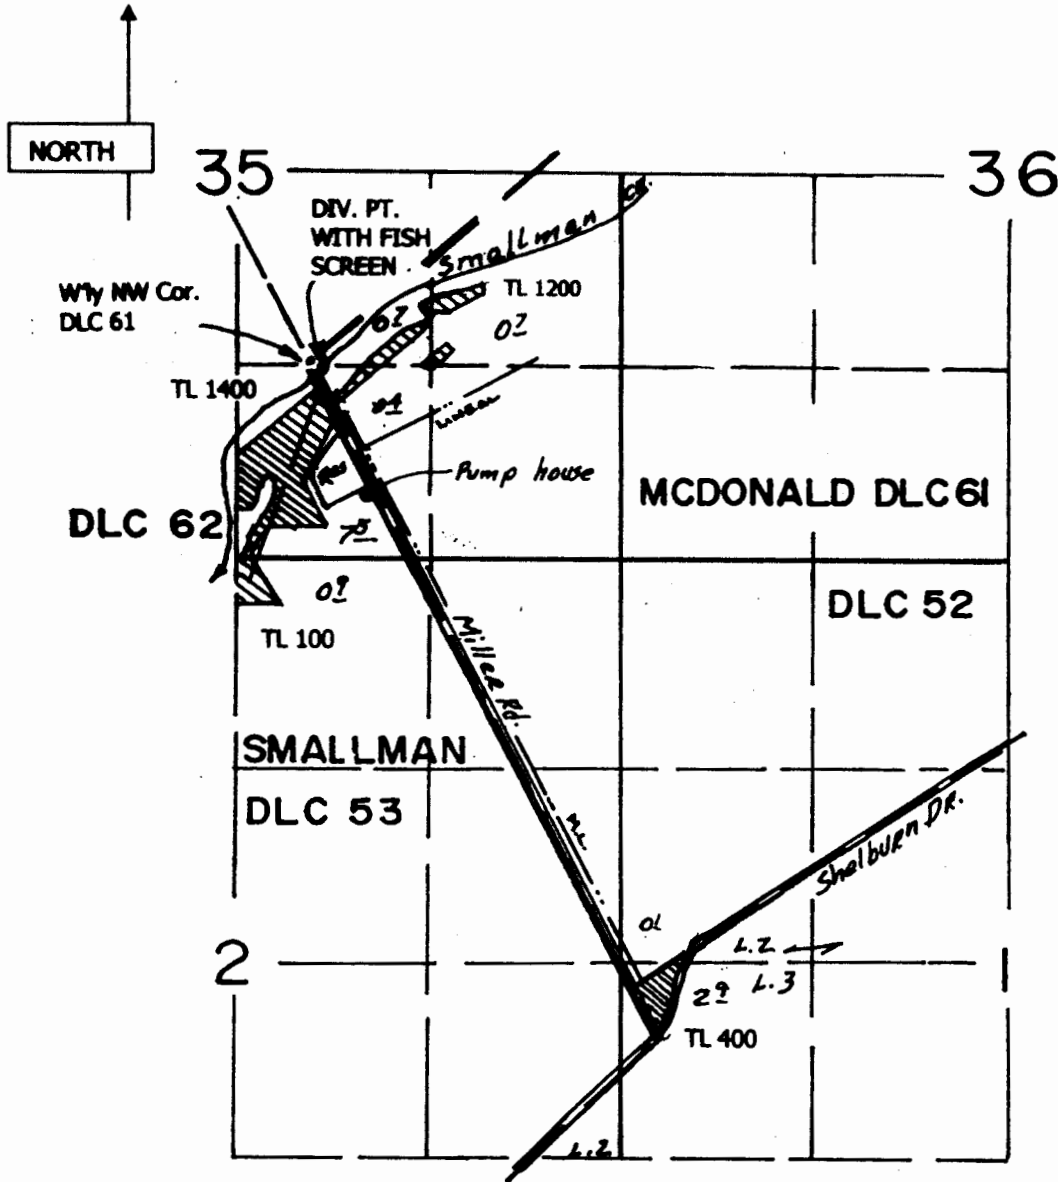

DIV. PT.: 90' S & 100' E from the W 1/4 NW corner DLC 61

Scale 4" = 1 mile

This map is not intended to provide legal dimensions or locations of property ownership lines.

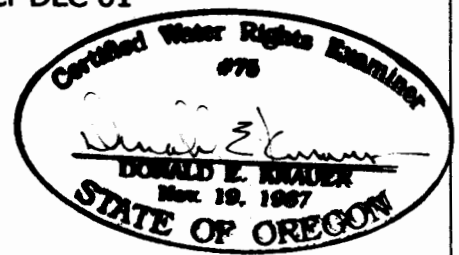

RENEWAL DATE: 6-30-07