


T. 30 S., R. 5 W., W.M.

SCALE: 1" = 400'

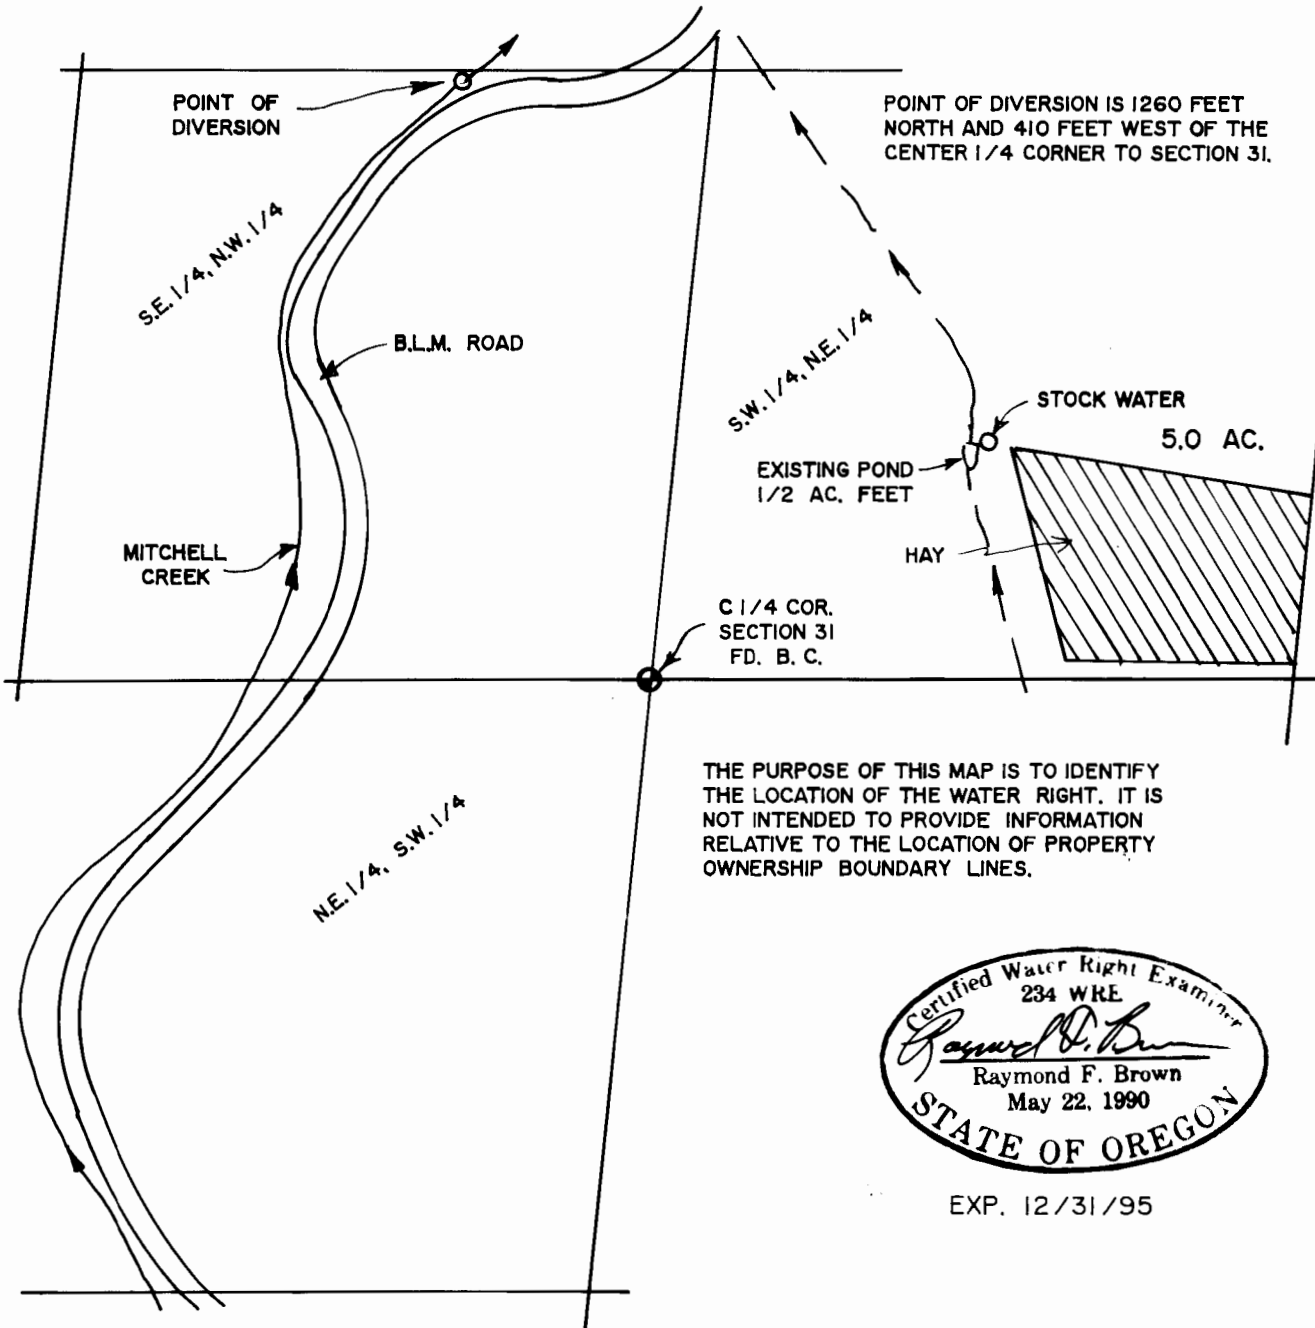

EXP. 12/31/95

FINAL PROOF SURVEY UNDER

Application No. T-6739 . Permit No. 17281

IN NAME OF

GEORGE D. DAWSON

Surveyed JUNE 7, 1995 by R.F. BROWN