


T.32S.,R.3E.,W.M.  
TAX LOT No. 32 3E 33 - 2500

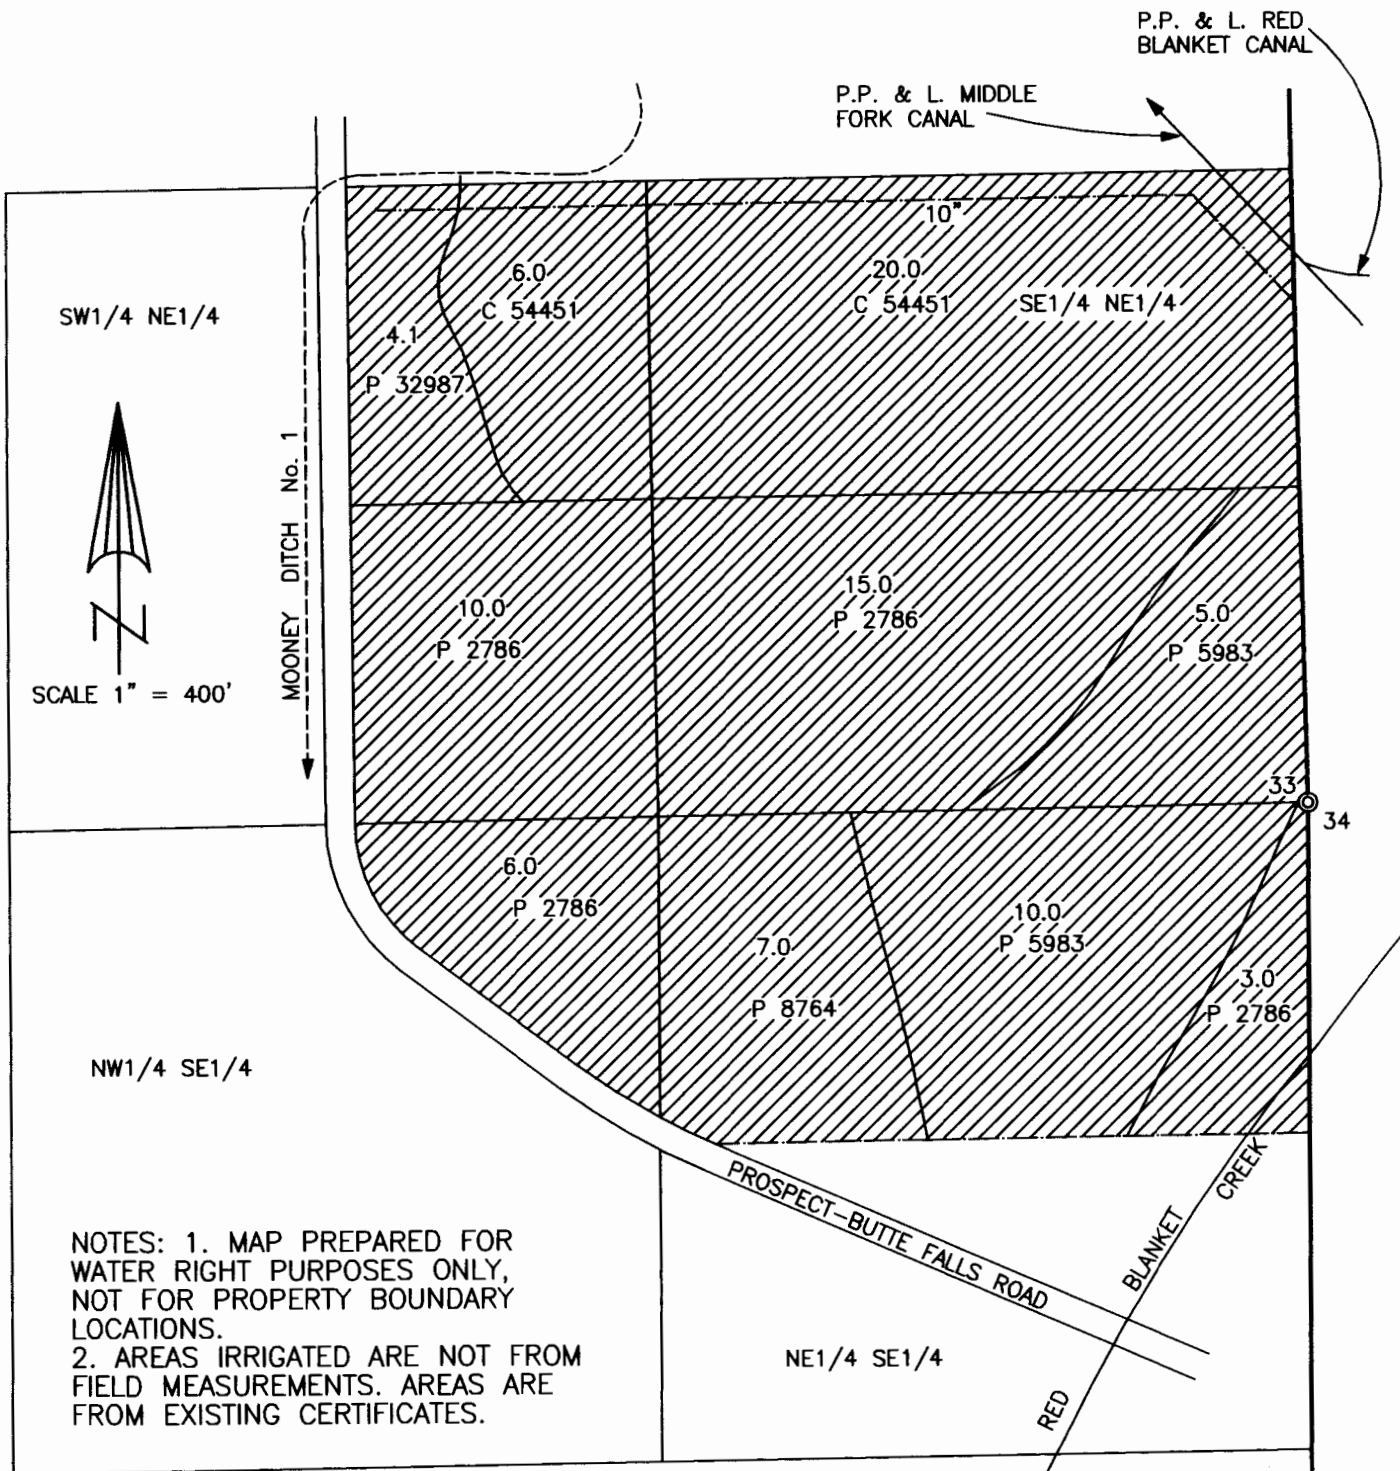


CLAIM OF BENEFICIAL USE MAP **RECEIVED**

APPLICATION No. T-8106

IN THE NAME OF:  
ALLEN AND KIM MARSHAL  
637 BUTTE FALLS - PROSPECT HIGHWAY  
PROSPECT, OR 97536

SEP 24 2007  
WATER RESOURCES DEPT  
SALEM OREGON

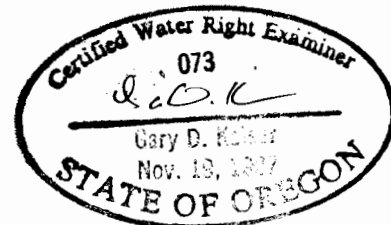


MAP PREPARED SEPTEMBER 6, 2007 BY GARY D. KAISER

T.32S.,R.3E.,W.M.

TAX LOT No. 32 3E 34-500



SCALE 1" = 400'

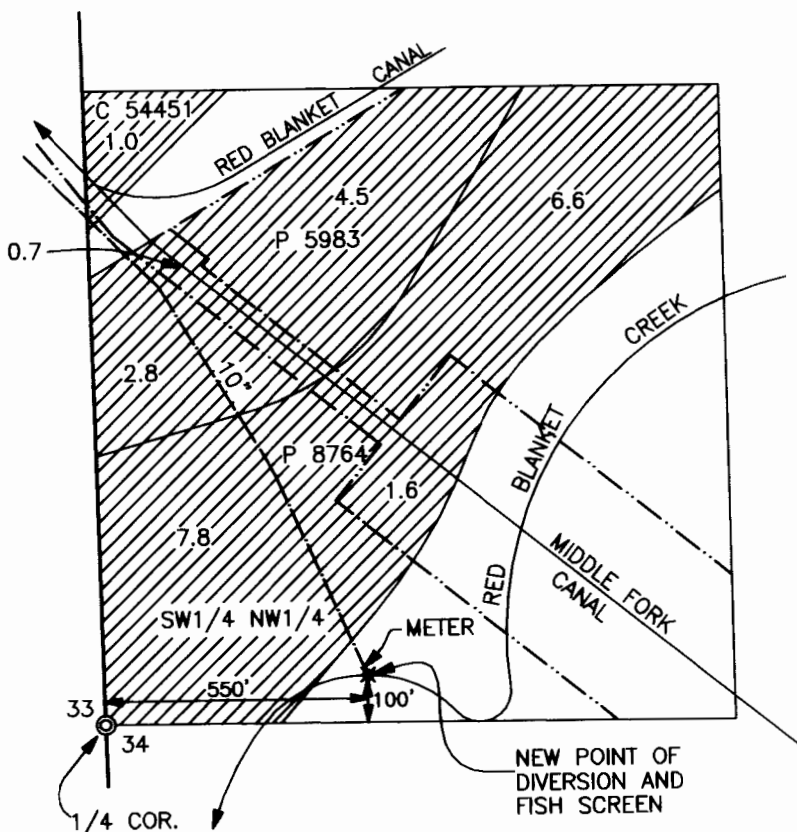

NOTES: 1. MAP PREPARED FOR WATER RIGHT PURPOSES ONLY, NOT FOR PROPERTY BOUNDARY LOCATIONS.  
 2. AREAS IRRIGATED ARE NOT FROM FIELD MEASUREMENTS. AREAS ARE FROM EXISTING CERTIFICATES.

CLAIM OF BENEFICIAL USE MAP


APPLICATION No. T-8106

IN THE NAME OF:  
 ALLEN AND KIM MARSHAL  
 637 BUTTE FALLS - PROSPECT HIGHWAY  
 PROSPECT, OR 97536

**RECEIVED**

SEP 24 2007

WATER RESOURCES DEPT  
SALEM OREGON

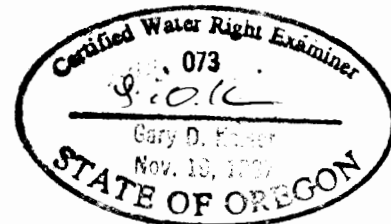

MAP PREPARED SEPTEMBER 6, 2007 BY GARY D. KAISER