


T.32S.,R.3E.,W.M.
TAX LOT No. 32 3E 33 - 2500

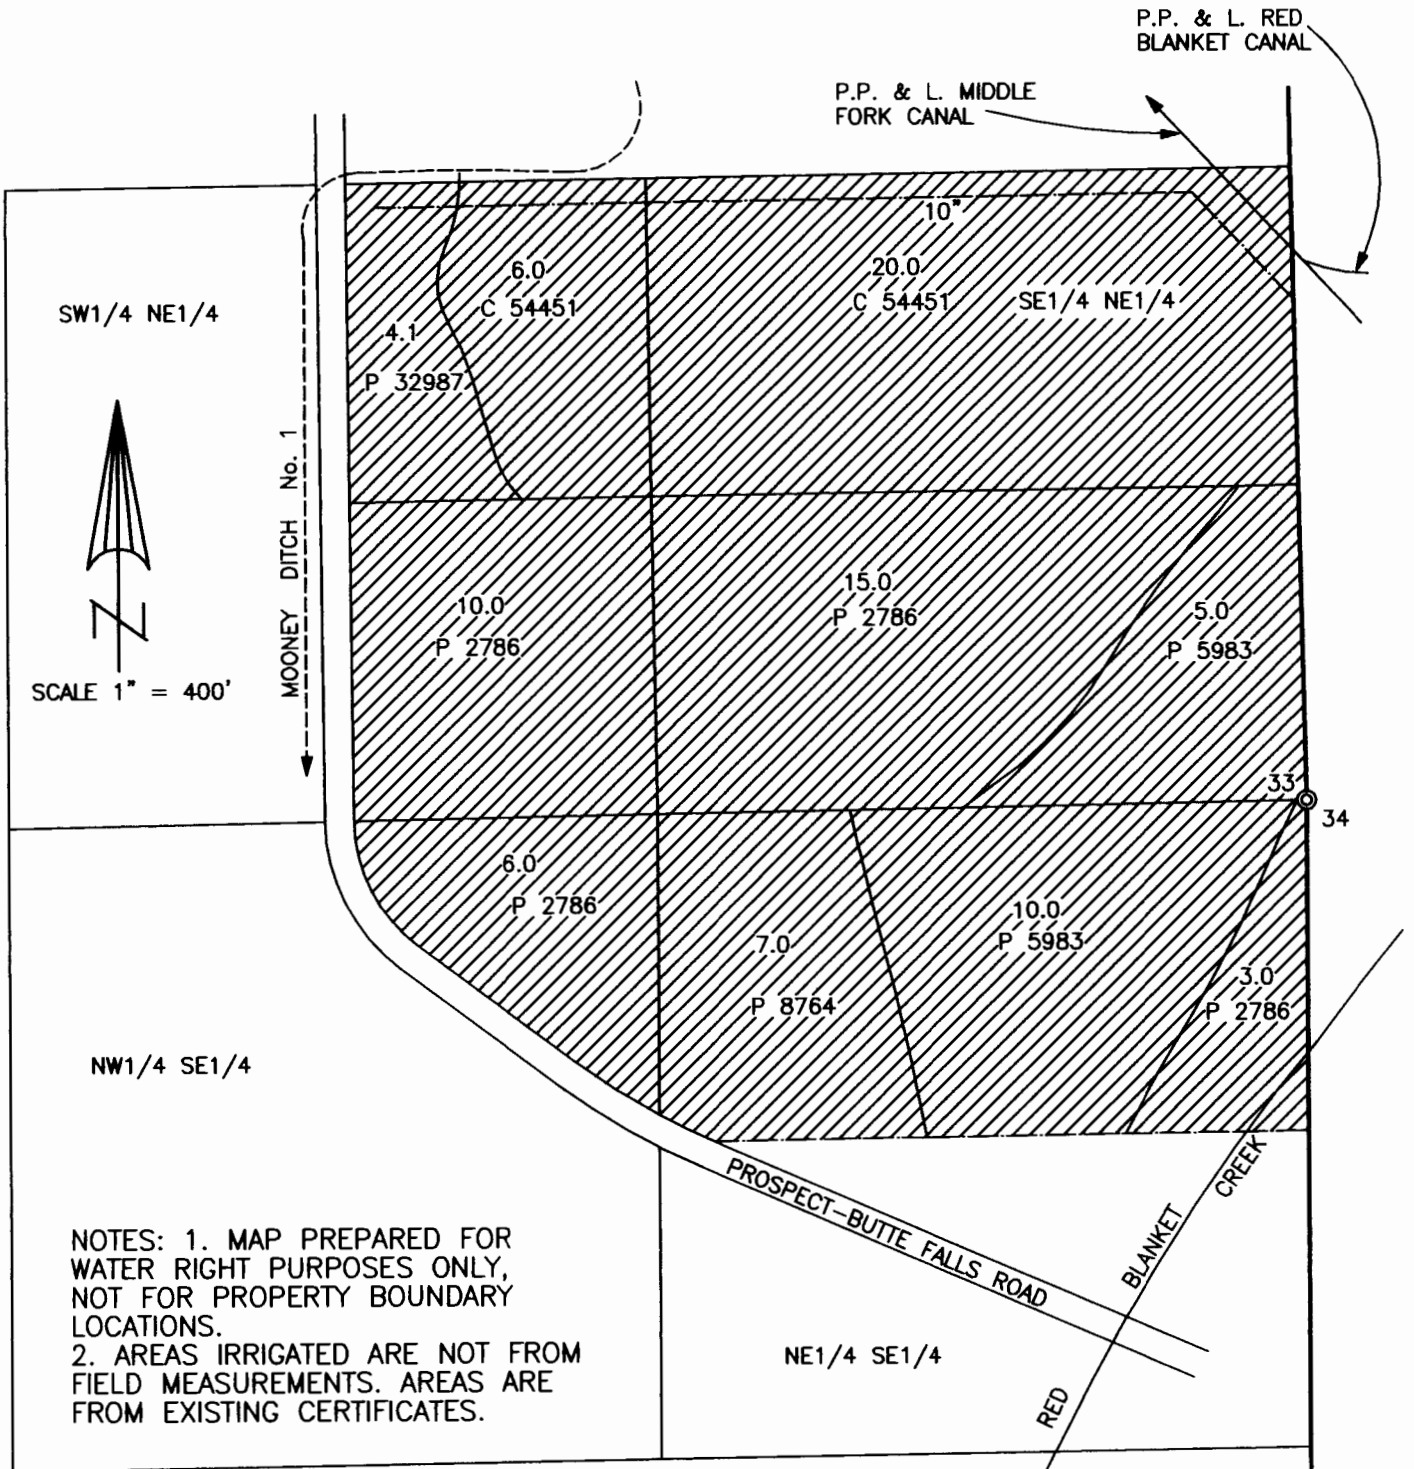


NOTES: 1. MAP PREPARED FOR WATER RIGHT PURPOSES ONLY, NOT FOR PROPERTY BOUNDARY LOCATIONS.
 2. AREAS IRRIGATED ARE NOT FROM FIELD MEASUREMENTS. AREAS ARE FROM EXISTING CERTIFICATES.

CLAIM OF BENEFICIAL USE MAP **RECEIVED**

APPLICATION No. T-8106

IN THE NAME OF:
 ALLEN AND KIM MARSHAL
 637 BUTTE FALLS - PROSPECT HIGHWAY
 PROSPECT, OR 97536



SEP 24 2007
 WATER RESOURCES DEPT
 SALEM OREGON

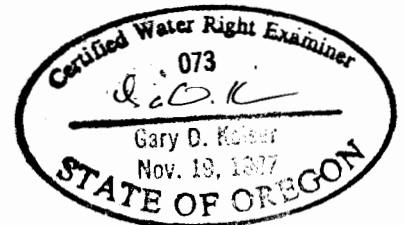

MAP PREPARED SEPTEMBER 6, 2007 BY GARY D. KAISER

T.32S.,R.3E.,W.M.

TAX LOT No. 32 3E 34-500

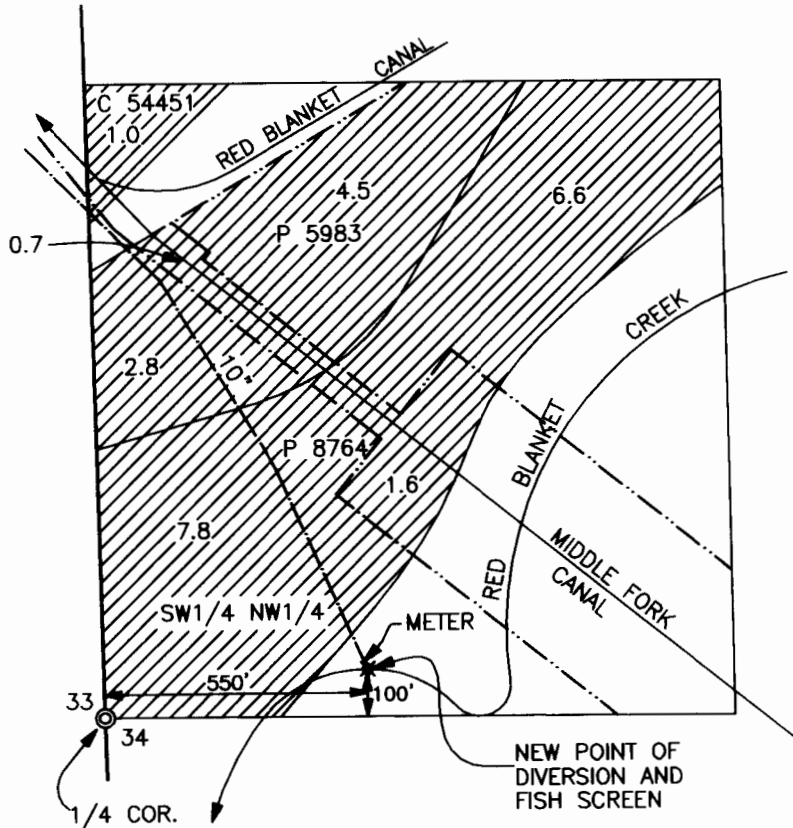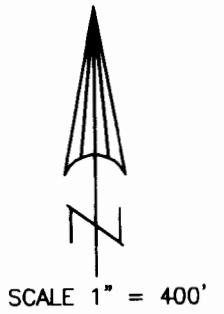

NOTES: 1. MAP PREPARED FOR WATER RIGHT PURPOSES ONLY, NOT FOR PROPERTY BOUNDARY LOCATIONS.
 2. AREAS IRRIGATED ARE NOT FROM FIELD MEASUREMENTS. AREAS ARE FROM EXISTING CERTIFICATES.

CLAIM OF BENEFICIAL USE MAP


APPLICATION No. T-8106

IN THE NAME OF:
 ALLEN AND KIM MARSHAL
 637 BUTTE FALLS - PROSPECT HIGHWAY
 PROSPECT, OR 97536

RECEIVED

SEP 24 2007

WATER RESOURCES DEPT
SALEM OREGON

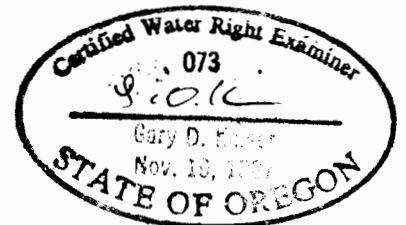

MAP PREPARED SEPTEMBER 6, 2007 BY GARY D. KAISER