


T.32S.,R.3E.,W.M.
TAX LOT No. 32 3E 33 - 2500

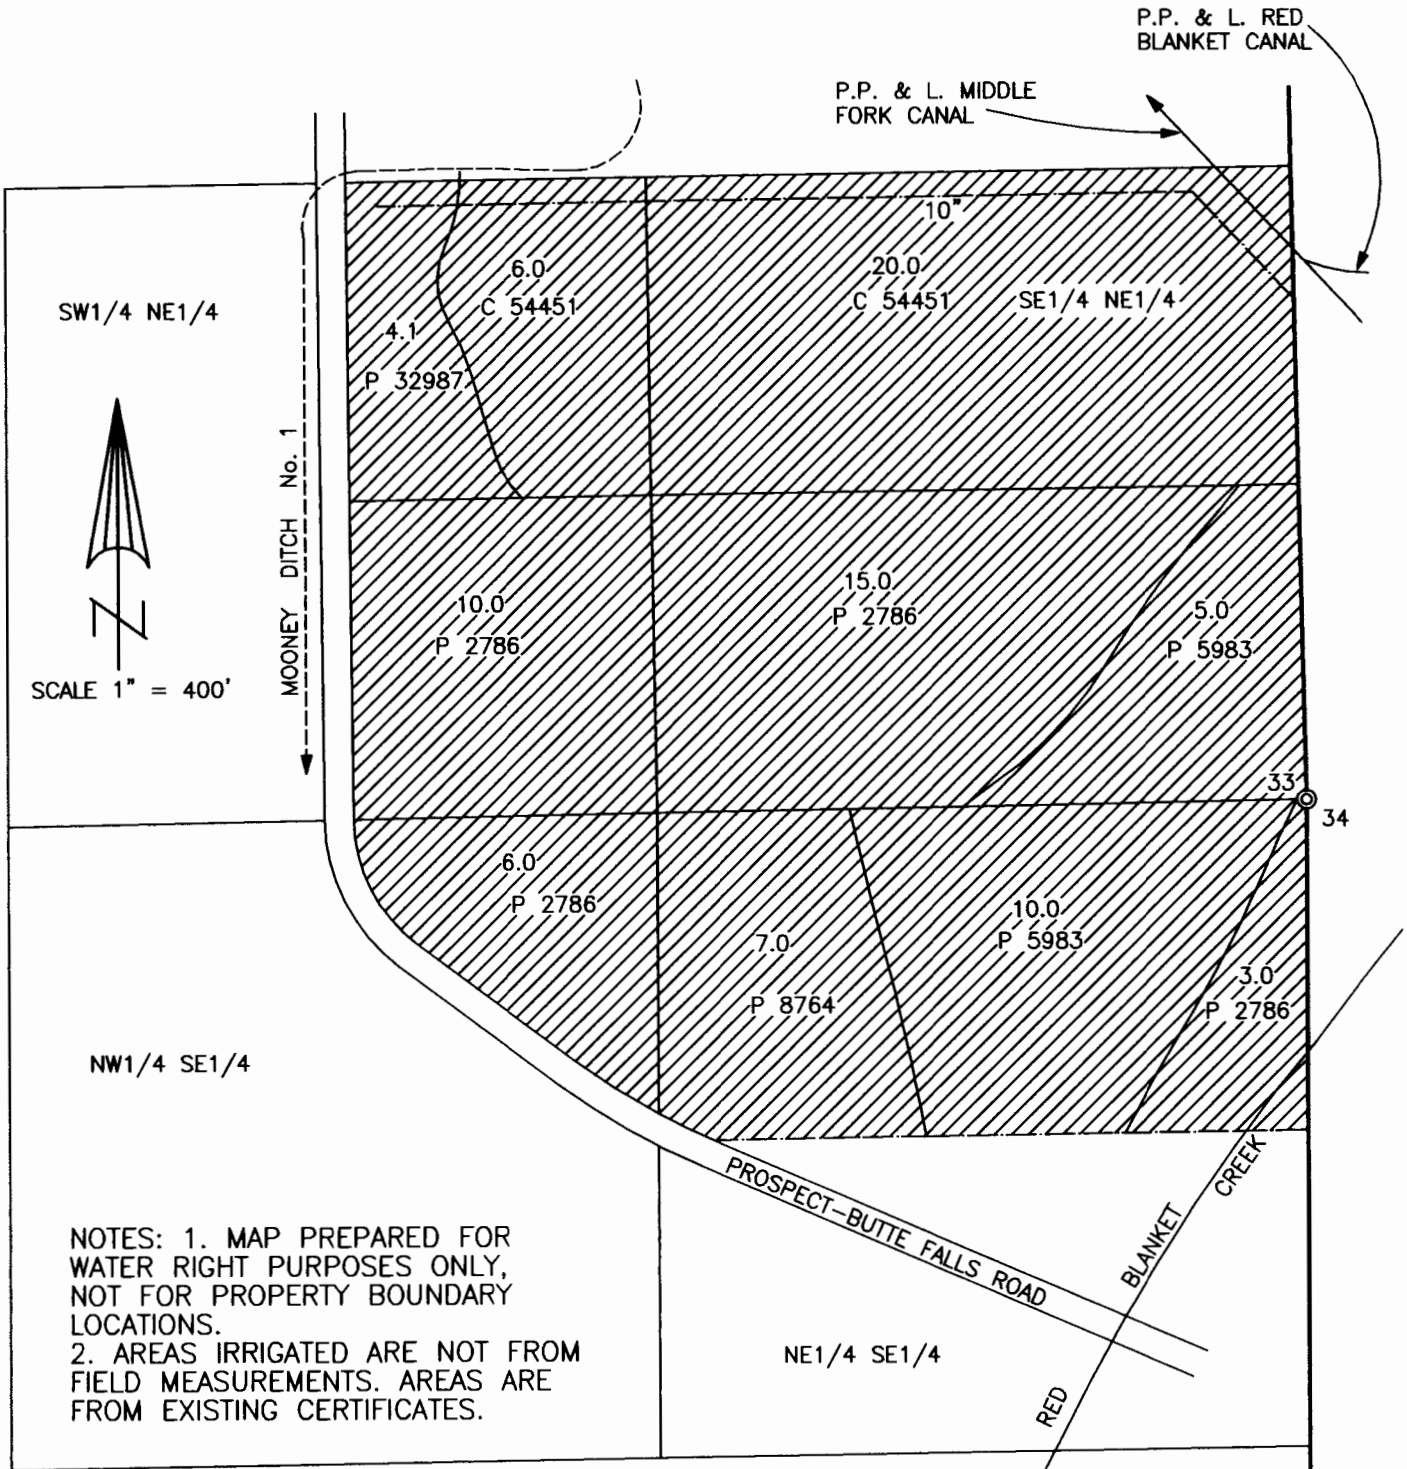


CLAIM OF BENEFICIAL USE MAP **RECEIVED**

APPLICATION No. T-8106



IN THE NAME OF:
ALLEN AND KIM MARSHAL
637 BUTTE FALLS - PROSPECT HIGHWAY
PROSPECT, OR 97536

SEP 24 2007
WATER RESOURCES DEPT
SALEM OREGON

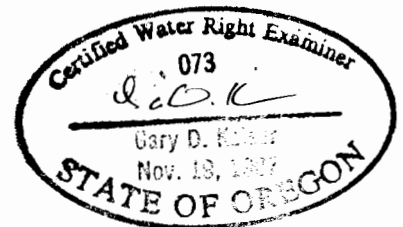

MAP PREPARED SEPTEMBER 6, 2007 BY GARY D. KAISER

T.32S.,R.3E.,W.M.
TAX LOT No. 32 3E 34-500

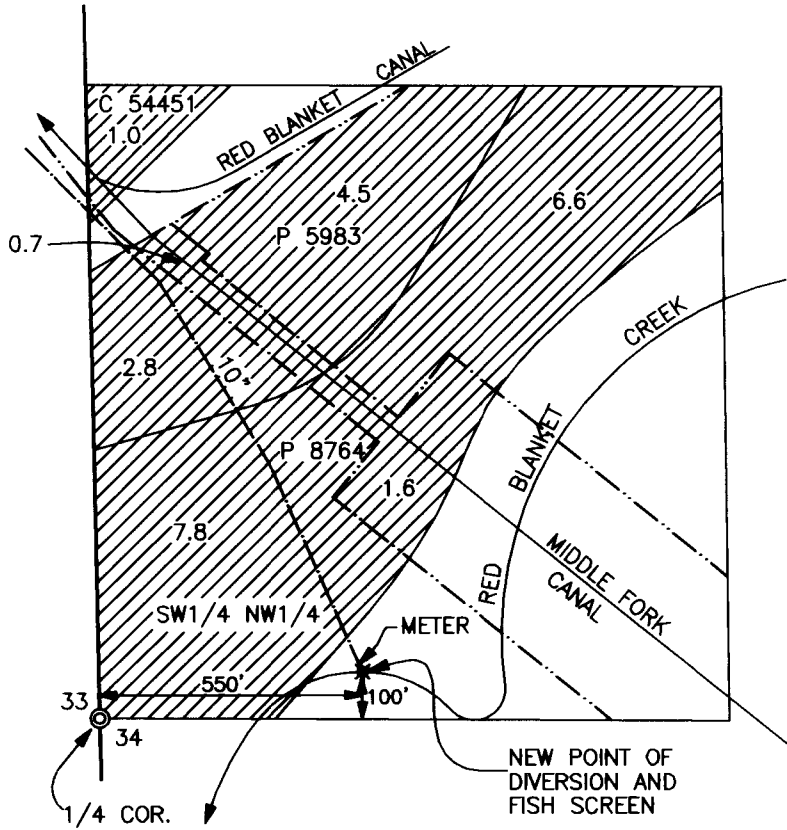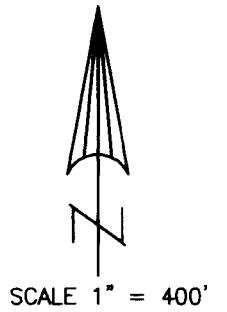


NOTES: 1. MAP PREPARED FOR WATER RIGHT PURPOSES ONLY, NOT FOR PROPERTY BOUNDARY LOCATIONS.
2. AREAS IRRIGATED ARE NOT FROM FIELD MEASUREMENTS. AREAS ARE FROM EXISTING CERTIFICATES.

CLAIM OF BENEFICIAL USE MAP

APPLICATION No. T-8106

IN THE NAME OF:
ALLEN AND KIM MARSHAL
637 BUTTE FALLS - PROSPECT HIGHWAY
PROSPECT, OR 97536

RECEIVED
SEP 24 2007
WATER RESOURCES DEPT
SALEM OREGON

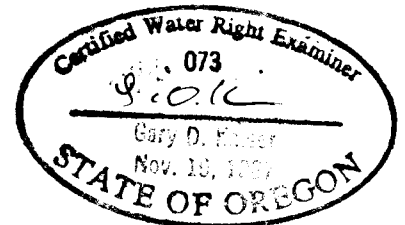

MAP PREPARED SEPTEMBER 6, 2007 BY GARY D. KAISER