


RECEIVED

OCT 1 2 1998

WATER RESOURCES DEPT.  
SALEM, OREGON

T. 15S. R. 4 & 5 W. W. M.

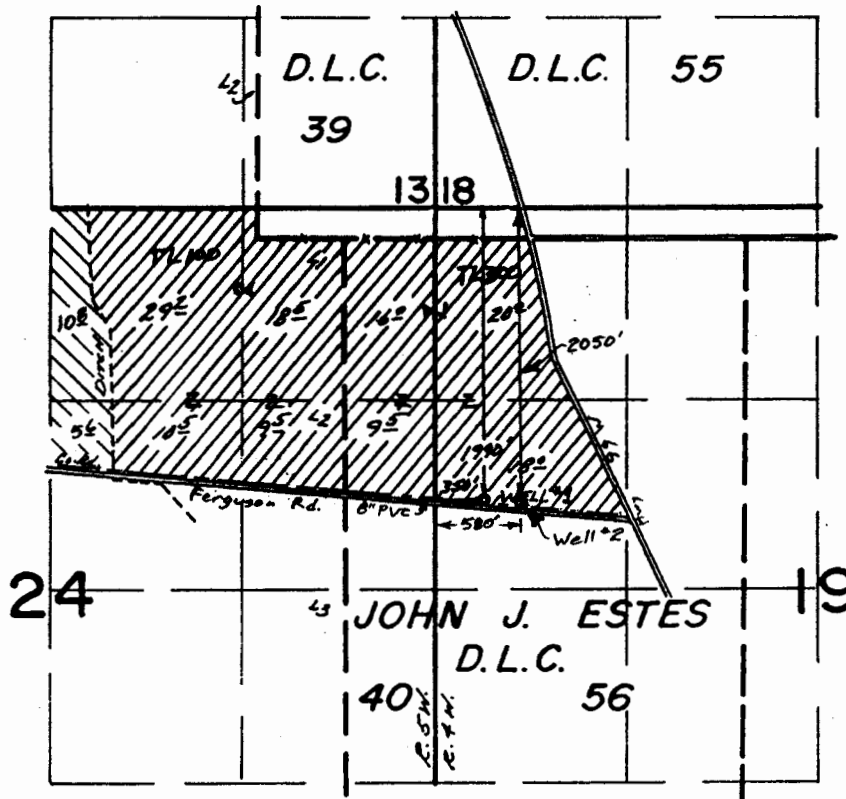

T-7254 (hatched symbol) C-49201

T-7768 (hatched symbol) App G-12974 Per G-11739

Surveyed March 26, 1998

Claim of Beneficial Use Map  
for  
NIXON FARMS, INC.

T-7254

T-7768

App G-12974, Per G-11739



This map is for the purpose of  
locating a water right only  
and has no intent to provide  
legal dimensions or the location  
of property lines.

**ESTES SURVEYS**

6293 Sunnyview Rd. NE  
Salem, OR 97305  
(503) 585-7593

60382 Arnold Rd.  
Bend, OR 97702  
(503) 382-7391